


STATE OF KANSAS
STATE CORPORATION COMMISSION

Give All Information Completely
Make Required Affidavit
Mail or Deliver Report to:
Conservation Division
State Corporation Commission
800 Biting Building
Wichita, Kansas

WELL PLUGGING RECORD

15-065-00436-00-00

NORTH

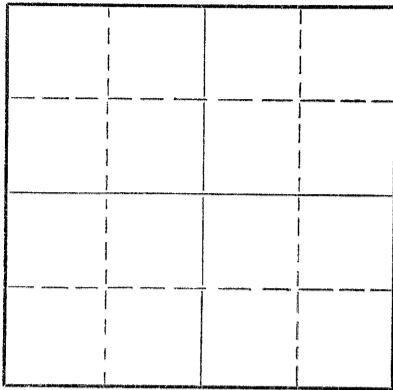

Locate well correctly on above
Section Plat

Graham

County. Sec. 21 Twp. 8 Rge. 21 (E) (W)

Location as "NE/CNW/SW" or footage from lines C/ SW/4 NE/4 SE/4

Lease Owner Midstates Oil Corporation

Lease Name Fred Newell "A" Well No. 1

Office Address Seventh Floor Midstates Bldg., Tulsa, Oklahoma

Character of Well (completed as Oil, Gas or Dry Hole) Dry Hole

Date well completed January 4, 19 54

Application for plugging filed January 4, 19 54

Application for plugging approved January 4, 19 54

Plugging commenced January 4, 19 54

Plugging completed January 4, 19 54

Reason for abandonment of well or producing formation Dry Hole

If a producing well is abandoned, date of last production None 19

Was permission obtained from the Conservation Division or its agents before plugging was commenced? Yes

Name of Conservation Agent who supervised plugging of this well Mr. Eldon Petty Hays, Kansas

Producing formation None Depth to top None Bottom None Total Depth of Well 3690 Feet

Show depth and thickness of all water, oil and gas formations.

OIL, GAS OR WATER RECORDS

CASING RECORD

FORMATION	CONTENT	FROM	TO	SIZE	PUT IN	PULLED OUT
		0	1638'	8-5/8"	1638'	None

Describe in detail the manner in which the well was plugged, indicating where the mud fluid was placed and the method or methods used in introducing it into the hole. If cement or other plugs were used, state the character of same and depth placed, from _____ feet to _____ feet for each plug set.

Halliburton Rubber Plug set @ 300' - 15 sacks cement - Set second Halliburton Rubber Plug @ 40' from surface - Filled to surface with cement.

(If additional description is necessary, use BACK of this sheet)

Name of Plugging Contractor Gabbert & Jones
Address Wichita, Kansas

STATE OF Oklahoma, COUNTY OF Tulsa, ss. W. H. Barclay

(employee of owner) of the above-described well, being first duly sworn on oath, says: That I have knowledge of the facts, statements, and matters herein contained and the log of the above-described well as filed and that the same are true and correct. So help me God.

(Signature) W. H. Barclay
7th Floor Midstates Bldg., Tulsa, Oklahoma
(Address)

SUBSCRIBED AND SWORN TO before me this 7th day of January, 19 54

My commission expires My Commission Expires March 21, 1955

Betty June Sawyer
Notary Public.

PLUGGING
FILE SEC. 21 T 8 R 21 W
BOOK PAGE 6 LINE 20

24-2675-S 2-52-20M

JAN 17 1954

1-13-54

CONSERVATION DIVISION
WICHITA, KANSAS

<u>Top</u>	<u>Bottom</u>	<u>Formation</u>
0	750	Surface Clay, Sand & Shale
750	1175	Shale & Sand
1175	1365	Shale
1365	1475	Shale w/ hard sand streaks
1475	1540	Shale & Hard sand
1540	1550	Pyrite
1550	1598	Shale & Pyrite
1598	1630	Shale
1630	1640	Anhydrite
1640	1925	Shale
1925	2520	Lime & Shale
2520	2780	Shale
2780	2915	Brown Lime & Shale
2915	2960	Lime & Shale
2960	3600	Lime
3600	3660	Lime & Shale
3660	3665	Conglomerate
3665	3690	Lime (Arbuckle)
	3690	Total Depth