


15-065-00260-00-00

WELL PLUGGING RECORD

Give All Information Completely
Make Required Affidavit
Mail or Deliver Report to:
Conservation Division
State Corporation Commission
800 Bitting Building
Wichita, Kansas

NORTH

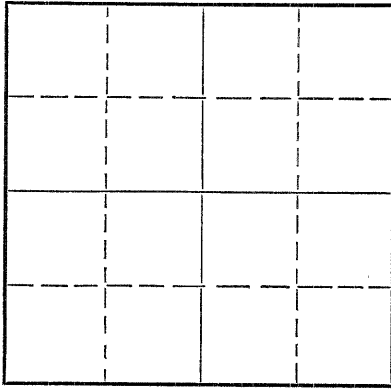

Locate well correctly on above
Section Plat

Graham County. Sec. 23 Twp. 8 Rge. (E) 21 (W)
Location as "NE/CNW $\frac{1}{4}$ SW $\frac{1}{4}$ " or footage from lines NE NE SW
Lease Owner Glickman Oil Company
Lease Name Ferland Well No. 1
Office Address 439 S. St. Francis, Wichita, Kansas
Character of Well (completed as Oil, Gas or Dry Hole) Dry Hole
Date well completed December 10, 19 51
Application for plugging filed December 10, 19 51
Application for plugging approved December 10, 19 51
Plugging commenced December 10, 19 51
Plugging completed December 10, 19 51
Reason for abandonment of well or producing formation _____

If a producing well is abandoned, date of last production _____ 19____
Was permission obtained from the Conservation Division or its agents before plugging was commenced? Yes

Name of Conservation Agent who supervised plugging of this well Eldon Petty, Hays, Kansas
Producing formation _____ Depth to top _____ Bottom _____ Total Depth of Well 3669 Feet
Show depth and thickness of all water, oil and gas formations.

OIL, GAS OR WATER RECORDS

CASING RECORD

Formation	Content	From	To	Size	Put In	Pulled Out
				8 5/8"	220'	Cemented

Describe in detail the manner in which the well was plugged, indicating where the mud fluid was placed and the method or methods used in introducing it into the hole. If cement or other plugs were used, state the character of same and depth placed, from _____ feet to _____ feet for each plug set.

Heavy mud from 3669 feet to 210 feet. Ran $\frac{1}{2}$ sack of cotton seed hulls and 15 sacks of cement, on top of plug. Mud to 40 feet ran plug and $\frac{1}{2}$ sack of cotton seed hulls and 10 sacks of cement. Cemented to base of cellar.

JAN 12 1952

1-12-52

(If additional description is necessary, use BACK of this sheet)
Name of Plugging Contractor The Veeder Supply & Development Company
Address P. O. Box 201
Cherryvale, Kansas

STATE OF KANSAS, COUNTY OF MONTGOMERY, ss.
FLOYD W. HILD (employee of owner) or (owner or operator) of the above-described well, being first duly sworn on oath, says: That I have knowledge of the facts, statements, and matters herein contained and the log of the above-described well as filed and that the same are true and correct. So help me God. THE VEEDER SUPPLY & DEVELOPMENT COMPANY

(Signature) Floyd W. Hild
P. O. Box 201, Cherryvale, Kansas
(Address)

SUBSCRIBED AND SWORN TO before me this 15th day of December, 19 51

My commission expires July 11, 1952 Coles Lawson Notary Public.

23 8 21W
131 5

15-005-00260-00-00

Company Glickman Oil Company

Sec. 23 T. 8 R. 21W

Farm Ferland

No. 1

Loc. NE NE SW

County Graham County, Kansas

Total Depth 3669'


Comm. 11-27-51

Comp. 12-10-51

Shot or Treated

Contractor Weeder Supply & Development Co.

Issued

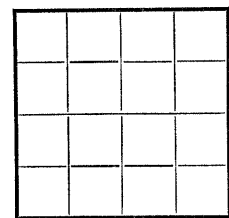

	Casing
20 in.	10 in
15 1/2	8 1/4
12 1/2	6 5/8
13 3/8	5 3/16

Drilled with Rig - D.
No. of Days - 14
No. of Bits -

Elevation

Production

Figures Indicate Bottom of Formation

Cellar	0	9	9
Gray Shale	9	100	91
Blue Shale	100	220	120
Shale Shells	220	400	180
Sand Shale	400	835	435
Shale Shells	835	895	60
Sand Shale	895	950	55
Shale Sand Shells	950	1100	150
Sand	1100	1325	225
Shale	1325	1345	20
Shale Shells	1345	1400	55
Red Bed Shale	1400	1582	182
Anhydrite	1582	1615	33
Shale Shells	1615	2080	465
Salt Shale Shells Iron	2080	2125	45
Shale Shells	2125	2230	105
Lime Shale	2230	2325	95
Lime	2325	2350	25
Lime Shale	2350	2690	340
Lime	2690	2810	120
Lime Shale	2810	3130	320
Lime	3130	3525	395
Lime Shale	3525	3570	45
Cherty Conglomerate	3570	3585	15
Conglomerate	3585	3615	30
Lime	3615	3669	54
Total Depth	3669'		

Plugged @ 210 feet with 15 sacks cement
Plugged @ 40 feet with 10 sacks cement

PLUGGING
NE SEC 23 T 8 R 21W
DATE 1/31 1952

JAN 12 1952

1-12-52

REGISTRATION