


Give All Information Completely
Make Required Affidavit
Mail or Deliver Report to:
Conservation Division
State Corporation Commission
211 No. Broadway
Wichita, Kansas

15-065-00627-00-00

WELL PLUGGING RECORD

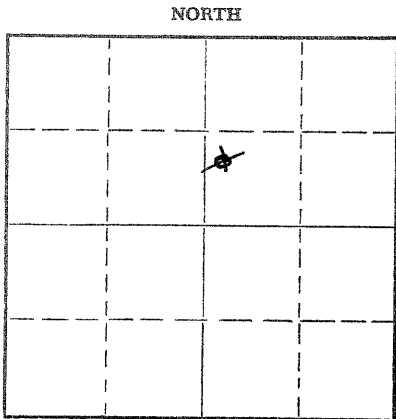

Locate well correctly on above
Section Plat

Graham County. Sec. 25 Twp. 8 Rge. 21 (E) (W)^X
Location as "NE/CNW/SW" or footage from lines 90' So. NW SW NE/4
Lease Owner I. O. Miller
Lease Name Thibault Thibault Well No. 1
Office Address P.O. Box 274 Ellis, Kansas
Character of Well (completed as Oil, Gas or Dry Hole) DH
Date well completed 12-19-58
Application for plugging filed "
Application for plugging approved "
Plugging commenced "
Plugging completed "
Reason for abandonment of well or producing formation _____

If a producing well is abandoned, date of last production _____ 19____
Was permission obtained from the Conservation Division or its agents before plugging was commenced? yes

Name of Conservation Agent who supervised plugging of this well Mr. Fabricius
Producing formation _____ Depth to top _____ Bottom _____ Total Depth of Well 3668 Feet
Show depth and thickness of all water, oil and gas formations.


OIL, GAS OR WATER RECORDS

CASING RECORD

FORMATION	CONTENT	FROM	TO	SIZE	PUT IN	PULLED OUT
		0	250	8 5/8	253	none

Describe in detail the manner in which the well was plugged, indicating where the mud fluid was placed and the method or methods used in introducing it into the hole. If cement or other plugs were used, state the character of same and depth placed, from _____ feet to _____ feet for each plug set.

Mudded to 600 ft - set plug w/ 20 sx cement
" 250 ft - set plug w/ 20 sx cement
" 40 ft - set plug w/ 10 sx cement

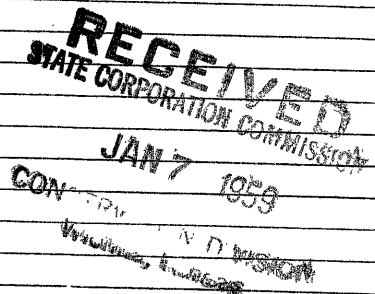

Name of Plugging Contractor Globe Oilwell Centg. Co.
Address Plainville, Kansas

STATE OF Kansas COUNTY OF Sedgwick, ss.
S. A. Murphy (employee of owner) or (owner or operator) of the above-described

well, being first duly sworn on oath, says: That I have knowledge of the facts, statements, and matters herein contained and the log of the above-described well as filed and that the same are true and correct. So help me God.

(Signature) S. A. Murphy
712 Brown Bldg.-Wichita 2, Kansas
(Address)

SUBSCRIBED AND SWORN TO before me this 19th day of December, 1958

My commission expires 2-5-61

Notary Public.

PLUGGING
FILE SEC 25 T. 8 R21W
BOOK PAGE 9 LINE 18

13065-00627-00-00

~~Thibault~~
Thibault # 1 - 90 ft. So. NW SW NE/4 Sec. 25-8-21 Graham County, Kans.
Company - I. O. Miller
Contractor - Virginia Drlg. Co Inc.
Commenced - Dec. 10, 1958
Completed - Dec. 19, 1958
Elevation 2076 DF
Total Depth - 3668 ft. 8 5/8 " set at 250 ft.

FORMATION	DEPTH	
Surface clay	0- 190	
Blue shale	190- 250	
Shale	250 - 600	
Sandy shale	600- 880	
Shale	880- 985	
Lime	985-1075	
Shale-lime	1075-1110	3292 - Heebner
Shale	1110-1135	3306 - Toronto
Sand	1135-1340	3320 - Lansing KO
Redbed shale	1340-1435	3538 - Base KO
Anhydrite	1435-1455	3622 - Cong.
Shale lime	1455-1620	3646 - Solid Arb.
Shale	1620-1625	3668 - TD
Anhydrite	1625-1670	
Shale-shells	1670-1785	
Lime-shale	1785-2400	
Lime	2400-2468	
Lime-shale	2468-3384	
Lime	3384-3470	
Lime-shale	3470-3542	
Lime	3542-3612	
Shale-lime	3612-3663	
Lime	3663-3668 TD	

Sa Murphy

Subscribed to and sworn before me, a Notary Public,
this 19th day of December, 1958.

Wm. H. Hart
Notary Public

My commission expires: 2-5-61

RECEIVED
STATE CORP. DIVISION
JAN 7 1959

PLUGGING			
FILE	SEC	25 T 8	R 21 W
BOOK	PAGE	4	LINE 18

1-7-59