

15-065-00322-0000

STATE OF KANSAS
STATE CORPORATION COMMISSION


Give All Information Completely
Make Required Affidavit
Mail or Deliver Report to:
Conservation Division
State Corporation Commission
800 Biting Building
Wichita, Kansas

WELL PLUGGING RECORD

Graham County. Sec. 29 Twp. 8S Rge. 21 (E) W (W)

Location as "NE/CNW%SW%" or footage from lines NE NE SW
Lease Owner Peel-Hardman Oil Producers
Lease Name Emery Well No. 1
Office Address P.O. Box 359, Hoisington, Kansas
Character of Well (completed as Oil, Gas or Dry Hole) Dry hole
Date well completed October 12, 1953
Application for plugging filed October 12, 1953
Application for plugging approved October 12, 1953
Plugging commenced October 12, 1953
Plugging completed October 12, 1953
Reason for abandonment of well or producing formation Dry Hole

NORTH

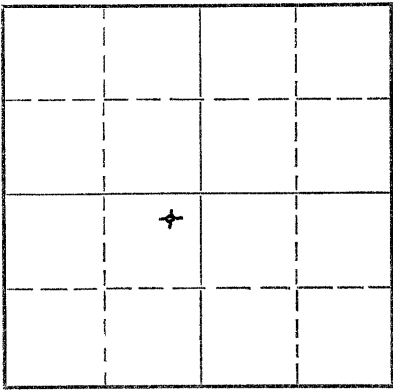

Locate well correctly on above
Section Plat

If a producing well is abandoned, date of last production 19
Was permission obtained from the Conservation Division or its agents before plugging was commenced? Yes

Name of Conservation Agent who supervised plugging of this well Eldon Petty
Producing formation _____ Depth to top _____ Bottom _____ Total Depth of Well 3765 Feet
Show depth and thickness of all water, oil and gas formations.

OIL, GAS OR WATER RECORDS

CASING RECORD

FORMATION	CONTENT	FROM	TO	SIZE	PUT IN	PULLED OUT
		0	157'	8 5/8"	157'	None

Describe in detail the manner in which the well was plugged, indicating where the mud fluid was placed and the method or methods used in introducing it into the hole. If cement or other plugs were used, state the character of same and depth placed, from _____ feet to _____ feet for each plug set.

From 3765' to 156 1/2' - heavy rotary mud
156 1/2' to 155' - wooden plug
155' to 109' - 15 sacks cement and 1/2 sack hulls
109' to 41 1/2' - heavy rotary mud
41 1/2' to 40' - wooden plug
40' to 6' - cement
6' to surface - cellar


Name of Plugging Contractor Glenn W. Peel (If additional description is necessary, use BACK of this sheet)
Address P.O. Box 359, Hoisington, Kansas 10-14-53

STATE OF KANSAS, COUNTY OF BARTON, ss.
Glenn W. Peel (employee of owner) or (owner or operator) of the above-described well, being first duly sworn on oath, says: That I have knowledge of the facts, statements, and matters herein contained and the log of the above-described well as filed and that the same are true and correct. So help me God. GLENN W. PEEL

(Signature) BY: *Herbert*
P.O. Box 359, Hoisington, Kansas (Address)

SUBSCRIBED AND SWORN TO before me this 12th day of October, 1953

My commission expires June 4, 1955 Notary Public. *Marian M. Herbert*

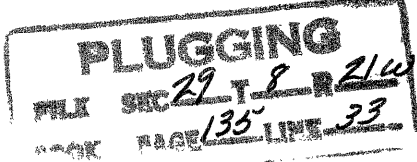

DRILLERS' LOG

Company: Peel-Hardman Oil Producers

NE NE SW

Farm Name: Emery Well No. 1

Sec. 29, Twp. 8S, Rge. 21W,

Depth: 3765'

County: Graham,
Kansas

Comm: 10-4-53 Comp: 10-12-53

Elevation:

Contractor: Glenn W. Peel

Casing: 8 5/8" 157' cem.

Production: Dry

Figures below indicate bottoms of formations:

Surface Clay	0	40
Shale, shells and snad		159
Shale		680
Sand and shale		950
Shale		1705
Anhydrite		1740
Shale		1750
Shale and shells		2150
Shale and lime		2195
Lime		2645
Lime and shale		2805
Shale		2915
Shale and lime		3050
Lime		3160
Shale and lime		3260
Lime		3765
Total Depth		3765

This is to certify that the above information is to the best of our knowledge, true and correct.

GLENN W. PEEL

BY: *Glenn W. Peel*

SUBSCRIBED AND SWORN to before me this 12th day of October, 1953.

My Commission expires June 4, 1955

Marian M. Herbert
Notary Public

REGISTERED
STATE OF KANSAS
COUNTY OF GRAHAM

10-14-53

PLUGGING
FILE SEC 29 T 8 R 21W
BOOK PAGE 135 LINE 33