


STATE OF KANSAS  
STATE CORPORATION COMMISSION

15-065-00911-00-00

Give All Information Completely  
Make Required Affidavit  
Mail or Deliver Report to:  
Conservation Division  
State Corporation Commission  
211 No. Broadway  
Wichita, Kansas

WELL PLUGGING RECORD

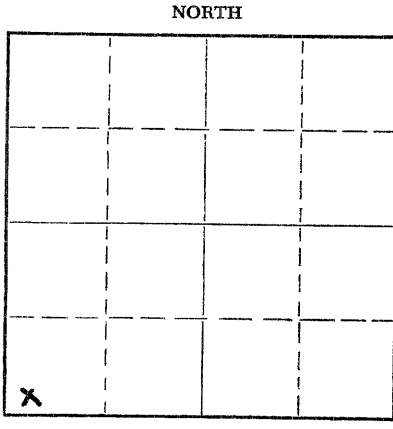

Locate well correctly on above Section Plat

Graham County. Sec. 29 Twp. 8S Rge. 21 (X) W (W)  
Location as "NE/CNW/SW" or footage from lines SW SW SW  
Lease Owner Artnell Company  
Lease Name Emery Well No. 1  
Office Address 101 Petroleum Building; Wichita, Kansas  
Character of Well (completed as Oil, Gas or Dry Hole) Dry Hole  
Date well completed December 18 19 56  
Application for plugging filed December 18 19 56  
Application for plugging approved December 18 19 56  
Plugging commenced December 18 19 56  
Plugging completed December 18 19 56  
Reason for abandonment of well or producing formation Dry

If a producing well is abandoned, date of last production \_\_\_\_\_ 19 \_\_\_\_  
Was permission obtained from the Conservation Division or its agents before plugging was commenced? Yes

Name of Conservation Agent who supervised plugging of this well Eldon Petty  
Producing formation \_\_\_\_\_ Depth to top \_\_\_\_\_ Bottom \_\_\_\_\_ Total Depth of Well 3766 Feet  
Show depth and thickness of all water, oil and gas formations.

OIL, GAS OR WATER RECORDS

CASING RECORD

FORMATION	CONTENT	FROM	TO	SIZE	PUT IN	PULLED OUT
				8 5/8"	179'	

Describe in detail the manner in which the well was plugged, indicating where the mud fluid was placed and the method or methods used in introducing it into the hole. If cement or other plugs were used, state the character of same and depth placed, from \_\_\_\_\_ feet to \_\_\_\_\_ feet for each plug set.

Mud up to 170'. Bottom Halliburton plug @ 170' with 20 sacks bulk cement. Top plug @ 30' with 10 sacks bulk cement.

(If additional description is necessary, use BACK of this sheet)

Name of Plugging Contractor Kan-Tex Drillers, Inc.  
Address 413 Beacon Building; Wichita 2, Kansas

STATE OF Kansas, COUNTY OF Sedgwick, ss.  
Harvey E. Nightingale (employee of owner) or (owner or operator) of the above-described well, being first duly sworn on oath, says: That I have knowledge of the facts, statements, and matters herein contained and the log of the above-described well as filed and that the same are true and correct. So help me God.

(Signature) Harvey E. Nightingale  
413 Beacon Building; Wichita 2, Kansas  
(Address)

SUBSCRIBED AND SWORN TO before me this 19th day of December, 19 56

My commission expires November 8, 1960

Frances E. Koenke  
Notary Public.

PLUGGING  
SEC. 29 T. 8. R. 21W  
CORNER PAGE 127 L. E. 18

REC. STATE COM. DIVISION  
DEC 27 1956  
CONSERVATION DIVISION  
WICHITA, KANSAS  
12-27-56

DRILLERS' LOG

No. 1 Emery  
SW SW SW of Section 29-8S-21W  
Graham County, Kansas

FROM	TO	
0	180	Surface and shale
180	770	Shale and sand
770	1225	Sand and shale
1225	1260	Shale and sand
1260	1480	Sand
1480	1753	Red Bed and shale
1753	1790	Anhydrite
1790	2240	Shale and shells
2240	2450	Shale and lime
2450	3084	Lime and shale
3084	3220	Shale and lime
3220	3335	Lime and shale
3335	3400	Shale and lime
3400	3430	Lime and shale
3430	3636	Lime
3636	3700	Lime and conglomerate
3700	3745	Cherty lime
3745	3755	Cherty conglomerate
3755	3766	Conglomerate
	3766	Rotary Total Depth D & A

COMMENCED: 12-9-1956

COMPLETED: 12-18-1956

CASING RECORD:

Set 8 5/8" surface casing  
at 179' with 165 sacks  
bulk cement, 2% Calcium  
Chloride.

STATE OF KANSAS )  
                          ) S S  
COUNTY OF SEDGWICK )

I hereby affirm that the above and foregoing is a true and correct copy of the formations encountered on the No. 1 Emery, SW SW SW of Section 29-8S-21W, Graham County, Kansas, as reflected by the daily drilling reports.

KAN-TEX DRILLERS, INC.

By: Harvey E. Nightingale  
Harvey E. Nightingale

Subscribed and sworn to before me this 19th day of December 1956

Frances E. Koenke  
Notary Public

My Commission Expires: November 8, 1960

12-22-56

PLUGGING  
FILE SEC. 29 T. 8 R. 21W  
BOOK PAGE 187 LINE 18