

75-065-00137-00-00

STATE OF KANSAS  
STATE CORPORATION COMMISSION

WELL PLUGGING RECORD

Give All Information Completely  
Make Required Affidavit  
Mail or Deliver Report to:  
Conservation Division  
State Corporation Commission  
800 Bitting Building  
Wichita, Kansas


OR  
FORMATION PLUGGING RECORD

Strike out upper line  
when reporting plug-  
ging off formations.

Graham County. Sec. 30 Twp. 8S Rge. (E) 21 (W)

Location as "NE $\frac{1}{4}$ NW $\frac{1}{4}$ SW $\frac{1}{4}$ " or footage from lines SE SE SE  
Lease Owner Nadel & Gussman  
Lease Name Newell Well No. 1  
Office Address Drawer 309, Tulsa 1, Oklahoma  
Character of Well (completed as Oil, Gas or Dry Hole) Dry Hole  
Date well completed May 16 19 50  
Application for plugging filed May 17 19 50  
Application for plugging approved May 25 19 50  
Plugging commenced May 17 19 50  
Plugging completed May 23 19 50  
Reason for abandonment of well or producing formation Dry Hole

NORTH

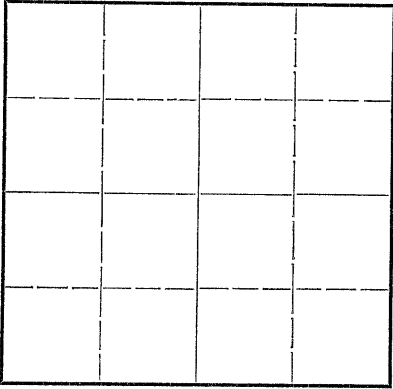

Locate well correctly on above  
Section Plat

If a producing well is abandoned, date of last production \_\_\_\_\_ 19\_\_\_\_  
Was permission obtained from the Conservation Division or its agents before plugging was com-  
menced? Yes

Name of Conservation Agent who supervised plugging of this well Mr. Eldon Petty  
Producing formation \_\_\_\_\_ Depth to top \_\_\_\_\_ Bottom \_\_\_\_\_ Total Depth of Well 3759 Feet  
Show depth and thickness of all water, oil and gas formations.

OIL, GAS OR WATER RECORDS

CASING RECORD

Formation	Content	From	To	Size	Put In	Pulled Out
				8 5/8"	162'	None
				5 1/2"	3746'	3216'

Describe in detail the manner in which the well was plugged, indicating where the mud fluid was placed and the method or methods used in introducing it into the hole. If cement or other plugs were used, state the character of same and depth placed, from \_\_\_\_\_ feet to \_\_\_\_\_ feet for each plug set.

Hole filled with mud from 3759' to 160'. Plug set at 160' in surface pipe and cemented with 15 sacks cement. Top plug set at 30' and cemented with 10 sacks cement. Plugged in accordance with rules and regulations of State Corporation Commission.

5-31-50

(If additional description is necessary, use BACK of this sheet)

Correspondence regarding this well should be addressed to Nadel & Gussman  
Address Drawer 309, Tulsa 1, Oklahoma

STATE OF Oklahoma, COUNTY OF Tulsa, ss. Herbert Gussman

(employee of owner) or (owner or operator) of the above-described well, being first duly sworn on oath, says: That I have knowledge of the facts, statements, and matters herein contained and the log of the above-described well as filed and that the same are true and correct. So help me God.

(Signature) Herbert Gussman

Drawer 309, Tulsa 1, Oklahoma  
(Address)

SUBSCRIBED AND SWORN TO before me this 29th day of May, 1950

Jack Brown  
Notary Public.

My commission expires April 1, 1953.

**PLUGGING**  
FILE SEC. 50-1-871-272-6M  
BOOK PAGE 7 LINE 44

WELL LOG

Nadel and Gussman

Newell No. 1

SE Cor. 30-88-21W  
Graham County, Kansas

Comm. 4-24-50  
Comp. 5-16-50

Casing: 8-5/9" @ 162' - 125 sax  
5-1/2" @ 3746' - 100 sax

Formations

Shale	168	
Shale and shells	575	
Shale, sand and pyrite	1165	
Shale	1245	
Sand	1480	
Shale	1743	
Anhydrite	1785	
Shale and red bed	2175	
Broken lime	2265	
Shale and lime	2755	
Shale and shells	2860	
Shale and lime	3419	
Shale	3423	
Lime	3636	
Shale	3653	
Lime and shale	3749	(Acidize with 500 gal. acid.
Arbuckle Dolomite	3752	(Hole full of water.
Arbuckle Lime	3759	T.D.

**PLUGGING**  
 FILE SEC 30T 8 21W  
 BOOK PAGE 7 LINE 41