

STATE OF KANSAS
STATE CORPORATION COMMISSION


15-065-00919-00-00

Give All Information Completely
Make Required Affidavit
Mail or Deliver Report to:
Conservation Division
State Corporation Commission
800 Bittling Building
Wichita, Kansas

WELL PLUGGING RECORD

Graham County, Sec. 30 Twp. 8 Rge. 21 (E) W(W)

Location as "NE/CNW/SW" or footage from lines NE NE SW
Lease Owner Harms-Burt Drilling Company
Lease Name Newell Well No. 1
Office Address Box 184, Great Bend, Kansas
Character of Well (completed as Oil, Gas or Dry Hole) Dry Hole
Date well completed January 29, 1956
Application for plugging filed January 29, 1956
Application for plugging approved January 29, (orally) 1956
Plugging commenced Plugging-January 29, 1956
Plugging completed January 29, 1956
Reason for abandonment of well or producing formation Dry Hole

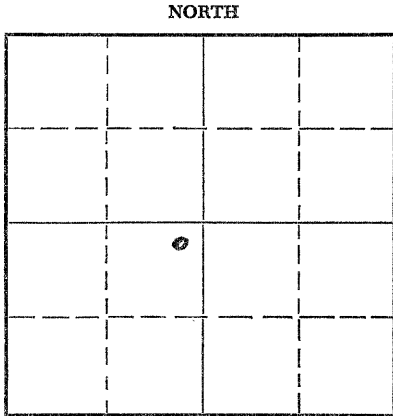

Locate well correctly on above Section Plat

If a producing well is abandoned, date of last production 19
Was permission obtained from the Conservation Division or its agents before plugging was commenced? _____

Name of Conservation Agent who supervised plugging of this well Eldon Petty, Box 326, Hays, Kansas
Producing formation _____ Depth to top _____ Bottom _____ Total Depth of Well _____ Feet
Show depth and thickness of all water, oil and gas formations.

OIL, GAS OR WATER RECORDS

CASING RECORD

FORMATION	CONTENT	FROM	TO	SIZE	PUT IN	PULLED OUT
Surface		0	201	8 5/8"	201	None

Describe in detail the manner in which the well was plugged, indicating where the mud fluid was placed and the method or methods used in introducing it into the hole. If cement or other plugs were used, state the character of same and depth placed, from _____ feet to _____ feet for each plug set.

Filled hole with mud from 3800' TD to 190' : Set plug at 190' with 15 sacks of cement on plug. Filled with heavy mud to 35' with plug set at 35' and 10 sacks of cement on plug.

(If additional description is necessary, use BACK of this sheet)
Name of Plugging Contractor Harms-Burt Drilling Co.,
Address Box 184, Great Bend, Kansas

STATE OF Kansas, COUNTY OF Barton, ss.
Allan Harms (employee of owner) or (owner or operator) of the above-described

well, being first duly sworn on oath, says: That I have knowledge of the facts, statements, and matters herein contained and the log of the above-described well as filed and that the same are true and correct. So help me God.

(Signature) Allan Harms

(Address)

SUBSCRIBED AND SWORN TO before me this 6 day of February, 1956

My commission expires 1-20-58
Mary E Van Pelt Notary Public.

24-7368-S 3-53-20M

PLUGGING
FILE SEC 30 T8 R 21W
BOOK PAGE 36 LINE 4

2-7-56

DRILLERS LOG

Company: Harms-Burt Drilling Co.
Farm: Newell #1 NE NE SW Section 30-8-21W, Graham County, Kansas
Commenced: January 19, 1956 Completed: January 30, 1956

Elevation: 2166 RB

0 - 160	soil & clay
160 - 690	shale
690 - 775	sand & shale
775 - 815	shale
815 - 1250	shale & shells
1250 - 1430	shale & sand
1430 - 1705	shale & shells
1705 - 1735	Anhydrite
1735 - 1985	shale & red bed
1985 - 2320	shale & shells
2320 - 3200	lime & shale
3200 - 3370	shale & lime
3370 - 3425	lime & shale
3425 - 3590	lime
3590 - 3671	Conglomerate
3671 - 3700	conglomerate & shale
3700 - 3748	shale
3748 - 3758	chert & shale
3758 - 3800	Arbuckle
3800	T.D.

Set 210' of 8 5/8" surface pipe, cemented with 150 sks. of common cement and 3 sacks of calcium chloride.

Tops: Anhydrite 1705
 Heebner 3367
 K. C. 3406
 Arbuckle 3758

Drill Stem Test: #1 3445-3465 Open 1 1/4 hrs. Shut in 20 min
 Rec. 165' salt water. IFP 0#
 FFP 100# BHP 1135#

Ran electric log.

Dry, Plugged and Abandoned.

A F F I D A V I T

STATE OF KANSAS)
)SS.
 COUNTY OF BARTON)

I, Allan Harms, of the Harms-Burt Drilling Company, being first duly sworn on oath, say: That I have knowledge of the facts, statements and matters herein contained and the same are true and correct.

Allan Harms

Subscribed and sworn to before me this 6 day of February, 1956

My commission expires January 20, 1958.

Mary E Van Pelt
 Notary Public

2-7-56

PLUGGING
 FILE REC 30 T 8 R 21 W
 PAGE 36 LINE 4