


STATE OF KANSAS
STATE CORPORATION COMMISSION

15-065-02269-00-00
WELL PLUGGING RECORD

Give All Information Completely
Make Required Affidavit
Mail or Deliver Report to:
Conservation Division
State Corporation Commission
211 No. Broadway
Wichita, Kansas

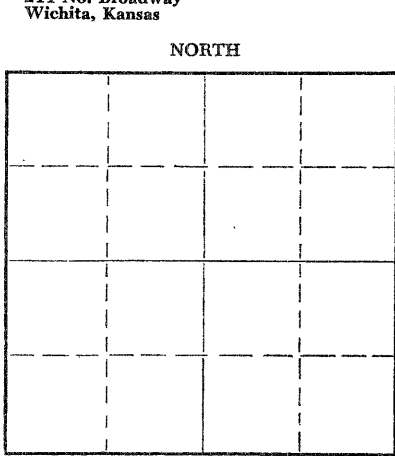

Locate well correctly on above
Section Plat

Graham County. Sec. 31 Twp. 8 Rge. (E) 21 (W)
Location as "NE/CNW $\frac{1}{2}$ SW $\frac{1}{2}$ " or footage from lines SE SE SE
Lease Owner Jones, Shelburne & Farmer, Inc.
Lease Name GLADYS Well No. 2
Office Address Russell, Kansas
Character of Well (completed as Oil, Gas or Dry Hole) Dry
Date well completed 2/21 19 57
Application for plugging filed 2/21 19 57
Application for plugging approved 2/21 19 57
Plugging commenced 2/21 19 57
Plugging completed 2/21 19 57
Reason for abandonment of well or producing formation Dry

If a producing well is abandoned, date of last production _____ 19____
Was permission obtained from the Conservation Division or its agents before plugging was commenced? Yes

Name of Conservation Agent who supervised plugging of this well Eldon Petty
Producing formation _____ Depth to top _____ Bottom _____ Total Depth of Well 3800 Feet
Show depth and thickness of all water, oil and gas formations.

OIL, GAS OR WATER RECORDS

CASING RECORD

FORMATION	CONTENT	FROM	TO	SIZE	PUT IN	PULLED OUT
				8-5/8	160	None

Describe in detail the manner in which the well was plugged, indicating where the mud fluid was placed and the method or methods used in introducing it into the hole. If cement or other plugs were used, state the character of same and depth placed, from _____ feet to _____ feet for each plug set.

1. Filled hole with heavy mud
2. Pushed plug to 155 feet
3. Dumped 1/2 sack hulls on top of plug
4. Mixed 15 sacks cement and dumped on top of hulls
5. Filled hole to top
6. Pushed plug to 40'
7. Dumped in 1/2 sack hulls
8. Mixed 10 sacks cement and filled hole to top with same.

(If additional description is necessary, use BACK of this sheet)

Name of Plugging Contractor Jones, Shelburne & Farmer, Inc.
Address Russell, Kansas

STATE OF Kansas, COUNTY OF Russell, ss.
JOHN O. FARMER (employee of owner) or (owner or operator) of the above-described well, being first duly sworn on oath, says: That I have knowledge of the facts, statements, and matters herein contained and the log of the above-described well as filed and that the same are true and correct. So help me God.
(Signature) John O. Farmer
Russell, Kansas
(Address)

SUBSCRIBED AND SWORN TO before me this 26th day of February, 19 57

My commission expires 10/11/58

RECEIVED Lucille Kennedy
STATE CORPORATION COMMISSION Notary Public.

PLUGGING FEB 27 1957 2-27-57
FILE NO. 31.18 CONSERVATION DIVISION
BOOK PAGE 143 LINE 7 Wichita, Kansas

