

15-065-21856-00-00


WELL PLUGGING RECORD

Give All Information Completely  
Make Required Affidavit  
Mail or Deliver Report to  
Conservation Division  
State Corporation Comm.  
245 North Water  
Wichita, KS 67202

Graham County, Sec. 7 Twp. 8S Rge. 21W E  
Location as "NE/CNW/SW" or footage from lines  
NW NE SE

Lease Owner L & A Oil Company  
Lease Name Kenyon-Hardman Well No. #2

Office Address P. O. Box 204, Bogue, Kansas 67625  
Character of Well (Completed as Oil, Gas or Dry Hole)  
Dry Hole

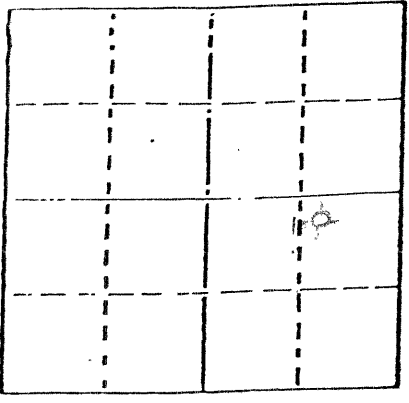

Locate well correctly on above Section Plot

Date Well completed September 14, 1983<sup>19</sup>  
Application for plugging filed September 14, 1983<sup>19</sup>  
Application for plugging approved September 14, 1983<sup>19</sup>  
Plugging commenced September 14, 1983<sup>19</sup>  
Plugging completed September 14, 1983<sup>19</sup>  
Reason for abandonment of well or producing formation  
Dry Hole

If a producing well is abandoned, date of last production  
N/A 19

Was permission obtained from the Conservation Division or its agents before plugging was commenced? Yes

Name of Conservation Agent who supervised plugging of this well Gil Balthazor  
Producing formation Depth to top Bottom Total Depth of Well 3566

Show depth and thickness of all water, oil and gas formations.

OIL, GAS OR WATER RECORDS

CASING RECORD

FORMATION	CONTENT	FROM	TO	SIZE	PUT IN	PULLED OUT
Sand				8 5/8"	243'	none

Describe in detail the manner in which the well was plugged, indicating where the mud fluid was placed and the method or methods used in introducing it into the hold. If cement or other plugs were used, state the character of same and depth placed, from feet to feet for each plug set.

3540' 20 SX  
1230' 20 SX  
810' 100 SX  
270' 40 SX  
40' 10 SX  
RH 10 SX  
50 - 50 POZ 6% gel 3% ccl 12:00 noon


(If additional description is necessary, use BACK of this sheet)

Name of Plugging Contractor Allied Cementing Company

DATE OF Oct 12 1983 COUNTY OF Graham, ss.  
Agnes M. Stephen, SS. (employee of owner) or (owner or operator)  
the above-described well, being first duly sworn on oath, says: That I have knowledge of the facts, statements, and matters herein contained and the log of the above-described well filed and that the same are true and correct. So help me God.

(Signature) Agnes M. Stephen  
Box 204 Bogue, KS 67625  
L & A Oil Co. (Address)

SUBSCRIBED AND SWORN TO before me this 18th day of October, 1983

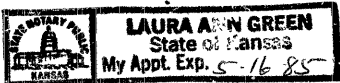

Laura Ann Green  
Laura Ann Green Notary Public.

commission expires May 16, 1985

RECEIVED  
STATE CORPORATION COMMISSION  
OCT 19 1983 10-19-83  
CONSERVATION DIVISION  
Wichita, Kansas