


WELL PLUGGING RECORD

Give All Information Completely
Make Required Affidavit
Mail or Deliver Report to:
Conservation Division
State Corporation Commission
212 No. Market
Wichita, Kansas

NORTH

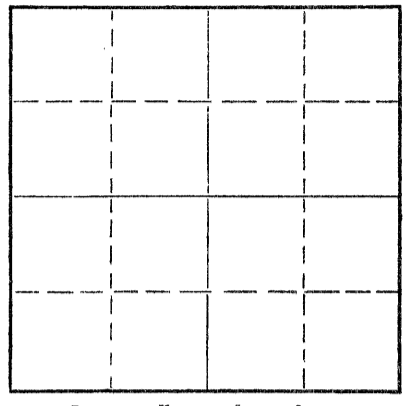

Locate well correctly on above
Section Plat

Graham County. Sec. 8 Twp. 8S Rge. (E) 21(W)
Location as "NE/CNW/SW" or footage from lines SW NE NE
Lease Owner Halliburton Oil Producing Company
Lease Name Leck Well No. 1
Office Address 520 Cameron Building - Okla. City, Okla
Character of Well (completed as Oil, Gas or Dry Hole) Dry Hole
Date well completed 10-9 19 68
Application for plugging filed 10-9 19 68
Application for plugging approved 10-9 19 68
Plugging commenced 10-9 19 68
Plugging completed 10-9 19 68
Reason for abandonment of well or producing formation Dry Hole

If a producing well is abandoned, date of last production 19
Was permission obtained from the Conservation Division or its agents before plugging was commenced? Yes

Name of Conservation Agent who supervised plugging of this well W. L. Nichols
Producing formation _____ Depth to top _____ Bottom _____ Total Depth of Well 3591 Feet
Show depth and thickness of all water, oil and gas formations.

OIL, GAS OR WATER RECORDS CASING RECORD

FORMATION	CONTENT	FROM	TO	SIZE	PUT IN	PULLED OUT
				8 5/8"	321'	none

Describe in detail the manner in which the well was plugged, indicating where the mud fluid was placed and the method or methods used in introducing it into the hole. If cement or other plugs were used, state the character of same and depth placed, from _____ feet to _____ feet for each plug set.

Plugged with 85 sacks Posmix 6% gel @ 690'

RECEIVED
STATE CORPORATION COMMISSION
OCT 16 1968 OCT 16, 1968
CONSERVATION DIVISION
Wichita, Kansas

(If additional description is necessary, use BACK of this sheet)
Name of Plugging Contractor Leben Drilling, Inc.
Address Box 486, Great Bend, Kansas

STATE OF KANSAS, COUNTY OF BARTON, ss.
Leslie Kite (employee of owner) or (owner or operator) of the above-described well, being first duly sworn on oath, says: That I have knowledge of the facts, statements, and matters herein contained and the log of the above-described well as filed and that the same are true and correct. So help me God.

(Signature) Leslie Kite

SUBSCRIBED AND SWORN TO before me this 14th day of October, 19 68

My commission expires April 1, 1971
Ulanda Nichols (Address) Notary Public.

DRILLER'S LOG

COMPANY	Halliburton Oil Producing Company
CONTRACTOR	LEBEN DRILLING, INC.
FARM	LECK #1
LOCATION	SW NE NE SECTION 8-8S-21W GRAHAM COUNTY, KANSAS
COMMENCED	10-2-68
COMPLETED	10-9-68

0	60	Sand, Clay, Sand
60	100	Sand, Post Rock
100	590	Shale
590	1090	Sand, Shale
1090	1305	Sand
1305	1581	Shale, Red Bed
1581	1615	Anhydrite
1615	2495	Shale
2495	2675	Shale, Lime
2675	3185	Lime, Shale
3185	3590	Lime
	<u>3591</u>	<u>RTD - D. & A.</u>

8 5/8" 20# new surface casing set @ 321' cemented with 60/40 HA5

I Leslie Kite, do hereby certify that the above and foregoing is a true and correct copy of the log of the Leck #1 Well, located SW NE NE of Section 8, Township 8 South, Range 21 West, Graham County, Kansas, as reflected by the records of Leben Drilling, Inc.

Leslie Kite

Leslie Kite

STATE OF KANSAS)
) SS
COUNTY OF BARTON)

RECEIVED
STATE CORPORATION COMMISSION
OCT 16 1968 *OCT 16, 1968*
CONSERVATION DIVISION
Wichita, Kansas

Subscribed and sworn to and before me, a Notary Public, in and for Barton County, Kansas, this 14th day of October, 1968.

Ulanda Nichols

Ulanda Nichols

My Commission Expires:
April 1, 1971