


15-065-00719-00-00

WELL PLUGGING RECORD

Give All Information Completely
Make Required Affidavit
Mail or Deliver Report to:
Conservation Division
State Corporation Commission
800 Bitting Building
Wichita, Kansas

Graham County. Sec. 9 Twp. 8 Rge. 21 (E) (W)
Location as "NE/CNW $\frac{1}{4}$ SW $\frac{1}{4}$ " or footage from lines NE NE SE
Lease Owner Trans Era Petroleum, Inc.
Lease Name Sayers-Kenyon Well No. 1
Office Address Box 232, Russell, Kansas
Character of Well (completed as Oil, Gas or Dry Hole) Dry Hole
Date well completed 8/9/55 19
Application for plugging filed 8/8/55 19
Application for plugging approved 8/8/55 19
Plugging commenced 8/8/55 19
Plugging completed 8/8/55 19
Reason for abandonment of well or producing formation Dry Hole

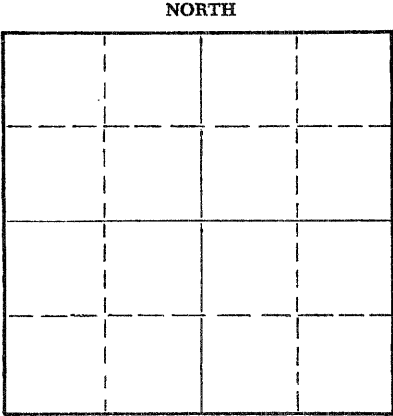

Locate well correctly on above Section Plat

If a producing well is abandoned, date of last production _____ 19____
Was permission obtained from the Conservation Division or its agents before plugging was commenced? _____

Name of Conservation Agent who supervised plugging of this well Eldon Petty
Producing formation _____ Depth to top _____ Bottom _____ Total Depth of Well 3585 Feet
Show depth and thickness of all water, oil and gas formations.

OIL, GAS OR WATER RECORDS

CASING RECORD

FORMATION	CONTENT	FROM	TO	SIZE	PUT IN	PULLED OUT
				8 5/8	207	none

Describe in detail the manner in which the well was plugged, indicating where the mud fluid was placed and the method or methods used in introducing it into the hole. If cement or other plugs were used, state the character of same and depth placed, from _____ feet to _____ feet for each plug set.

PLUGGING REPORT

Filled with heavy mud to 200'. Set 8 5/8 plug, using 1/2 sack hulls and 20 sacks cement. Filled hole with heavy mud to 35' and set 2nd 8 5/8 plug, using 1/3 sacks hulls and 10 sacks cement.

(If additional description is necessary, use BACK of this sheet)

Name of Plugging Contractor Trans Era Petroleum, Inc.
Address Box 232, Russell, Kansas

STATE OF KANSAS, COUNTY OF RUSSELL, ss.
Robert B. Snyder (employee of owner) or (owner or operator) of the above-described well, being first duly sworn on oath, says: That I have knowledge of the facts, statements, and matters herein contained and the log of the above-described well as filed and that the same are true and correct. So help me God.

(Signature) Robert B. Snyder
(Address) _____

SUBSCRIBED AND SWORN TO before me this 18th day of August, 19 55

Margie Cooper
Notary Public.

My commission expires 1-30--57

PLUGGING
FILE SEC 9 T 8 R 21W
BOOK PAGE 142 LINE 8



RECEIVED
STATE CORPORATION COMMISSION

AUG 11 1955

CONSERVATION DIVISION
Wichita, Kansas

8-19-55

Trans Era Petroleum, Inc.
SAYERS-KENYON #1

NE NE SE 9-8-21
Graham County,
Kansas

Total Depth: 3585

Comm: 7/29/55
Comp: 8/9/55

15-065-00719-00-00

Casings:

Cement

8 5/8 @ 207

140 sacks of Bulk

FORMATION	DEPTH
Sand & Gravel	40
Gravel & Shells	125
Shale & Shells	207
Shale	330
Shale, Sand & shells	450
Shale	560
Sand	610
Shale & sand	680
Sand	710
Shale & sand	785
Shale & Shells	1060
Sand	1285
Shale & Shells	1290
Shale, Sand & Lime	1390
Red Bed -- Gray Shale	1480
Shale, shells	1540
Blue shale	1550
Anhydrite	1595
Shale & shells	2160
Shale & lim ed	3210
Lime	3542
Conglomerate	3557
Arbuckle	3585

STATE OF KANSAS)
) ss:
COUNTY OF RUSSELL)

I hereby certify that the above information is true and correct to the best of my knowledge.

Robert B. Snyder

Subscribed and sworn to before me this 18th day of August, 1955.

Margie Cooper

My commission expires: 1-30-57

PLUGGING
FILE SEC 9 T 8 R 21W
BOOK PAGE 112 LINE 8

RECEIVED
STATE OF KANSAS

8-19-55