


15-065-00128-00-00

STATE OF KANSAS
STATE CORPORATION COMMISSION

Give All Information Completely
Make Required Affidavit
Mail or Deliver Report to:
Conservation Division
State Corporation Commission
800 Biffing Building
Wichita, Kansas

WELL PLUGGING RECORD

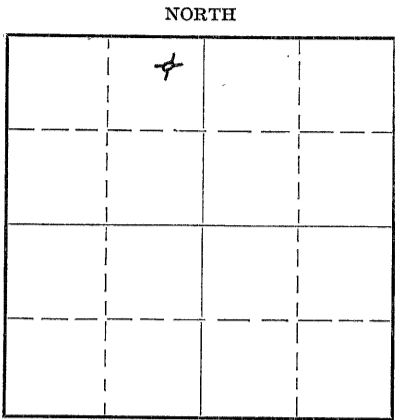

Locate well correctly on above
Section Plat

Graham County. Sec. 13 Twp. 8S Rge. (E) 21 (W)
Location as "NE/CNW $\frac{1}{4}$ SW $\frac{1}{4}$ " or footage from lines NE NE NW
Lease Owner Peel-Hardman
Lease Name Berland Well No. 1
Office Address P. O. Box 359, Hoisington, Kansas
Character of Well (completed as Oil, Gas or Dry Hole) Dry Hole
Date well completed October 17, 1950
Application for plugging filed October 17, 1950
Application for plugging approved October 17, 1950
Plugging commenced October 17, 1950
Plugging completed October 17, 1950
Reason for abandonment of well or producing formation Dry Hole

If a producing well is abandoned, date of last production 19
Was permission obtained from the Conservation Division or its agents before plugging was commenced? Yes

Name of Conservation Agent who supervised plugging of this well Eldon Petty
Producing formation _____ Depth to top _____ Bottom _____ Total Depth of Well 3600 Feet
Show depth and thickness of all water, oil and gas formations.

OIL, GAS OR WATER RECORDS

CASING RECORD

Formation	Content	From	To	Size	Put In	Pulled Out
		0	167'	8 5/8"	167'	None

Describe in detail the manner in which the well was plugged, indicating where the mud fluid was placed and the method or methods used in introducing it into the hole. If cement or other plugs were used, state the character of same and depth placed, from _____ feet to _____ feet for each plug set.

3600'	-	156 $\frac{1}{2}$ '	-	Heavy Rotary Mud
156 $\frac{1}{2}$ '	-	155'	-	Wooden Plug
155'	-	107'	-	15 sacks cement & 1 sack hulls
107'	-	41 $\frac{1}{2}$ '	-	Heavy Rotary Mud
41 $\frac{1}{2}$ '	-	40'	-	Wooden Plug
40'	-	6'	-	10 sacks cement & $\frac{1}{2}$ sack hulls
6'	-	Surface	-	Cellar

RECEIVED
STATE CORPORATION COMMISSION
OCT 21 1950
CONSERVATION DIVISION
Wichita, Kansas

(If additional description is necessary, use BACK of this sheet)
Correspondence regarding this well should be addressed to Peel-Hardman 1021-50
Address P. O. Box 359, Hoisington, Kansas

STATE OF Kansas, COUNTY OF Barton, ss.
Glenn Peel Drilling Company, Inc. (employee of owner) or owner of the above-described well,
being first duly sworn on oath, says: That I have knowledge of the facts, statements, and matters herein contained and the log of the above-described well as filed and that the same are true and correct. So help me God. GLENN PEEL DRILLING COMPANY, INC.

(Signature) BY: [Signature]
P. O. Box 359, Hoisington, Kansas
(Address)

SUBSCRIBED AND SWORN to before me this 20th day of October, 1950

My commission expires June 4, 1951 Marian M. Herfel Notary Public.

PLUGGING
FILE SEC 13 T & R 214
BOOK PAGE 32 LINE 1

15-065-00128-00-00

DRILLER'S LOG

Company: Peel-Hardman
N. Appleman Company
Aurora Gasoline Company

Sec. 13 Twp. 8S Rge. 21W
NE NE NW

Farm: Berland Well No. 1

County: Graham,
Kansas

Total Depth: 3600'

Comm.: 10-5-50 Comp.: 10-17-50
Contractor: Glenn Peel Drilling Co., Inc.
Casing:
8 5/8" 167' cem.

Elevation:

Production: Dry

Figures below indicate bottom of formations

Surface clay and Rock	0 -	40
Sand		60
Sand and Shale		190
Shale		435
Shale and Sand		1070
Sand		1250
Shale		1545
Anhydrite		1579
Shale and Shells		1785
Shale		1900
Shale w/streaks of broken lime		1960
Lime and Shale		2310
Lime		2475
Lime and Shale		2760
Shale and Broken Lime		2870
Shale and Lime		3155
Lime		3560
Arbuckle Lime		3600
Total Depth		3600

This is to certify that the above information is, to the best of our knowledge, true and correct.

10-21-50
RECEIVED
STATE CORPORATION COMMISSION
OCT 21 1950
CONSERVATION DIVISION
Wichita, Kansas

GLENN PEEL DRILLING COMPANY, INC.

BY: J. B. Anderson

SUBSCRIBED AND SWORN to before me this 20th day of October, 1950.

My commission expires June 4, 1951

Marian M. Herkert
Notary Public

PLUGGING
FILE SEC 13 T 8 R 21 W
BOOK PAGE 37 LINE 1