


15-065-00417-00-00

Give All Information Completely
Make Required Affidavit
Mail or Deliver Report to:
Conservation Division
State Corporation Commission
800 Bitting Building
Wichita, Kansas

WELL PLUGGING RECORD

NORTH

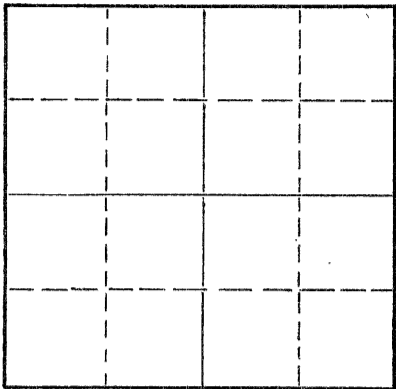

Locate well correctly on above
Section Plat

Graham County. Sec. 17 Twp. 8 Rge. 21 (E) (W)
Location as "NE/CNW/SW" or footage from lines SW SW SW
Lease Owner Bennett & Roberts Drilling Co.
Lease Name Kenyon Well No. 1
Office Address Russell, Kansas
Character of Well (completed as Oil, Gas or Dry Hole) Dry Hole
Date well completed 9-26- 19 54
Application for plugging filed 9-26- 19 54
Application for plugging approved 9-26- 19 54
Plugging commenced 9-26- 19 54
Plugging completed 9-26- 19 54
Reason for abandonment of well or producing formation

If a producing well is abandoned, date of last production 19
Was permission obtained from the Conservation Division or its agents before plugging was commenced? Yes

Name of Conservation Agent who supervised plugging of this well Eldon Petty
Producing formation Depth to top Bottom Total Depth of Well 3740 Feet
Show depth and thickness of all water, oil and gas formations.

OIL, GAS OR WATER RECORDS

CASING RECORD

FORMATION	CONTENT	FROM	TO	SIZE	PUT IN	PULLED OUT
				8 5/8	224	None

Describe in detail the manner in which the well was plugged, indicating where the mud fluid was placed and the method or methods used in introducing it into the hole. If cement or other plugs were used, state the character of same and depth placed, from feet to feet for each plug set.

Push plug to 210'. Cemented with 15 sacks, 1/2 sack hulls. Fill hole with heavy mud to 40'. Plug and 1/2 sack hulls. Cemented with 10 sacks of cement.

(If additional description is necessary, use BACK of this sheet)

Name of Plugging Contractor
Address


STATE OF KANSAS, COUNTY OF RUSSELL, ss.
Harold Wurst (employee of owner) or (owner or operator) of the above-described well, being first duly sworn on oath, says: That I have knowledge of the facts, statements, and matters herein contained and the log of the above-described well as filed and that the same are true and correct. So help me God.

(Signature) Harold Wurst
Russell, Kansas (Address)

SUBSCRIBED AND SWORN TO before me this 28th day of September, 19 54.

Lillian J. Salmer
Notary Public.

My commission expires, 11-28-56

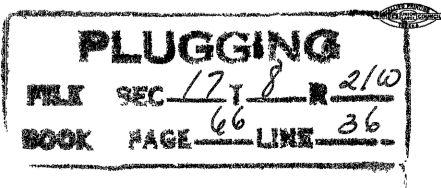

15-065-00417-00-00

Bennett & Roberts Drilling Co.
Kenyon #1

SW SW SW Sec. 17-8-21
Graham County, Kansas

R. T. D. 3740'

Comm: 9-16-54
Comp: 9-26-54

Set 8 5/8 @ 224' w/130 5x
Set

Formation:	Depth:
Surf. Soil & Sandy Clay	10'
Shale & Sand - hard stks of Sand	40
Sand - Hard stks of Clay	125
Shale	224
Shale & Shells	600
Shale & Sand	750
Sand	850
Shale & Sand	900
Shale & Shells	1150
Sand	1330
Shale & Redbed	1565
Sand & Shale	1630
Anhydrite	1665
Lime & Shale	1855
Shale & Lime	2280
Lime	2335
Shale & Lime	2920
Lime & Shale	3281
Lime	3610
Lime & Shale	3647
Lime	3650
Arbuckle	3706
Sandy Dolo.	3740

STATE OF KANSAS)
RUSSELL, COUNTY)SS.

I hereby certify that the above information is true and correct to
the best of my knowledge.

Miss Lake

Subscribed and sworn to before me this 28th day of September, 1954.

Lillian A. Palmer
Notary Public

My commission expires 11-28-56

9-29-54

PLUGGING
 FILE SEC 17 T 8 R 2160
 BOOK PAGE 66 LINE 36