


15-065-00150-00-00

STATE OF KANSAS
STATE CORPORATION COMMISSION

Give All Information Completely
Make Required Affidavit
Mail or Deliver Report to:
Conservation Division
State Corporation Commission
800 Biting Building
Wichita, Kansas

WELL PLUGGING RECORD

NORTH

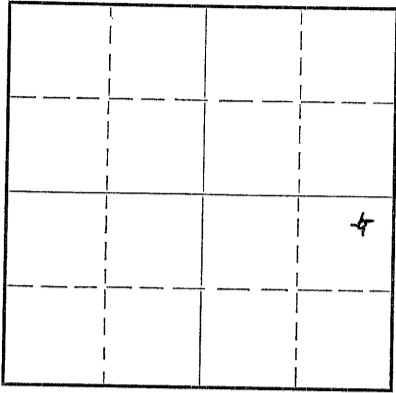

Locate well correctly on above
Section Plat

Graham

County. Sec. 18 Twp. 8S Rge. (E) 21 (W)

Location as "NE/CNW 1/4 SW 1/4" or footage from lines NE NE SE

Lease Owner Peel-Hardman

Lease Name Calhoun Well No. 1

Office Address P. O. Box 359, Hoisington, Kansas

Character of Well (completed as Oil, Gas or Dry Hole) Dry Hole

Date well completed August 18 19 50

Application for plugging filed Sept. 14 19 50

Application for plugging approved Sept. 14 19 50

Plugging commenced Sept. 14 19 50

Plugging completed Sept. 22 19 50

Reason for abandonment of well or producing formation Dry Hole

If a producing well is abandoned, date of last production 19

Was permission obtained from the Conservation Division or its agents before plugging was commenced? Yes

Name of Conservation Agent who supervised plugging of this well Mr. Eldon Petty

Producing formation Depth to top Bottom Total Depth of Well 3630 Feet

Show depth and thickness of all water, oil and gas formations.

OIL, GAS OR WATER RECORDS

CASING RECORD

Formation	Content	From	To	Size	Put In	Pulled Out
		0	220'	8 5/8"	220'	None
		0	3594'	5 1/2"	3594'	2859'

Describe in detail the manner in which the well was plugged, indicating where the mud fluid was placed and the method or methods used in introducing it into the hole. If cement or other plugs were used, state the character of same and depth placed, from feet to feet for each plug set.

3630' - 3590' - 5 sacks cement
 3590' - 216 1/2' - Heavy Rotary Mud
 216 1/2' - 215' - Rock Bridge
 215' - 169' - 15 sacks cement
 169' - 22 1/2' - Heavy Rotary Mud
 22 1/2' - 21' - Rock Bridge
 21' - 6' - 5 sacks cement
 6' - Surface - Celler

10-16-50
 RECEIVED
 STATE CORPORATION COMMISSION
 OCT 16 1950
 CONSERVATION DIVISION
 WICHITA, KANSAS

Correspondence regarding this well should be addressed to Peel-Hardman
Address P. O. Box 359, Hoisington, Kansas


STATE OF Kansas, COUNTY OF Barton, ss.
Peel-Hardman

(endorsement cover) or (owner or operator) of the above-described well, being first duly sworn on oath, says: That I have knowledge of the facts, statements, and matters herein contained and the log of the above-described well as filed and that the same are true and correct. So help me God. PEEL-HARDMAN

(Signature) BY: Ralph Bennett
P. O. Box 359, Hoisington, Kansas (Address)

SUBSCRIBED AND SWORN to before me this 14th day of October, 19 50

My commission expires June 1, 1951
Marian M. Hefert Notary Public

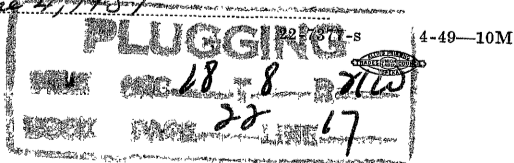

15-065-00190-00-0.0

DRILLER'S LOG

Company: Peel-Hardman Sec. 18 Twp. 8S Rge. 21W
 Farm: Calhoun Well No. 1 NE NE SE
 Total Depth: 3598' (Rotary) County: Graham,
 Contractor: Glenn Peel Drilling Co., Inc. Kansas
 Comm: 7-28-50 Comp: 8-5-50 Elevation:
 Casing: Production:
 8 5/8" 220' cem.
 5 1/2" 3594' cem.

Figures below indicate bottom of formations

Sand & Shale	0 -	160
Shale & Shells		221
Sand & Shale		1000
Shale & Shells		1115
Sand		1330
Shale & Red Bed		1595
Anhydrite		1635
Shale		1645
Shale & Shells		2010
Shale & Lime		2140
Shale & Shells		2360
Lime & Shale		3275
Lime		3598
Total Depth		3598

This is to certify that the above information is, to the best of our knowledge, true and correct.

GLENN PEEL DRILLING COMPANY, INC.

BY: *Glenn Herbert*

SUBSCRIBED AND SWORN to before me this 10th day of August, 1950

My commission expires June 4, 1957 *Marion M. Herold*
 Notary Public

PLUGGING
 FILE SEC. 18 T. 8 R. 21W
 BOOK PAGE 77 LINE 17

RECORDED
 8-12-50
 AUG 12 1950
 STATE OF KANSAS