


STATE OF KANSAS  
STATE CORPORATION COMMISSION

15-065-00357-00-00

Get All Information Completely  
Make Required Affidavit  
Mail or Deliver Report to:  
Conservation Division  
State Corporation Commission  
800 Bifling Building  
Wichita, Kansas

WELL PLUGGING RECORD

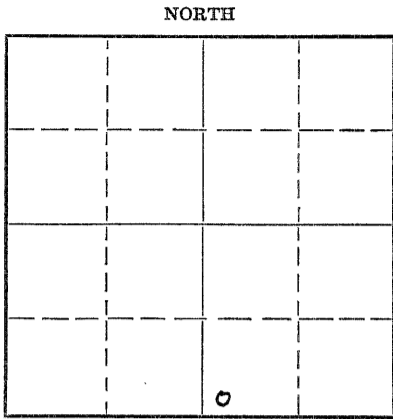

Locate well correctly on above  
Section Flat

Graham County. Sec. 18 Twp. 8 Rge. 21 (W)  
Location as "NE/CNW $\frac{1}{4}$ SW $\frac{1}{4}$ " or footage from lines SW SW SE  
Lease Owner Taxman Oil Company  
Lease Name Louise Calhoun Well No. 1  
Office Address Kansas City, Missouri  
Character of Well (completed as Oil, Gas or Dry Hole) Dry Hole  
Date well completed March 17 19 52  
Application for plugging filed March 17 19 52  
Application for plugging approved March 17 19 52  
Plugging commenced March 17 19 52  
Plugging completed March 17 19 52  
Reason for abandonment of well or producing formation

If a producing well is abandoned, date of last production 19  
Was permission obtained from the Conservation Division or its agents before plugging was commenced? Yes

Name of Conservation Agent who supervised plugging of this well Eldon Petty  
Producing formation Depth to top Bottom Total Depth of Well 3660 Feet  
Show depth and thickness of all water, oil and gas formations.

OIL, GAS OR WATER RECORDS

CASING RECORD

Formation	Content	From	To	Size	Put In	Pulled Out
		surface	195'	8-5/8		

Describe in detail the manner in which the well was plugged, indicating where the mud fluid was placed and the method or methods used in introducing it into the hole. If cement or other plugs were used, state the character of same and depth placed, from feet to feet for each plug set.

Filled hole to 185'. Plug at 185' 1/2 sack hulls and 15 sacks cement. #2 Plug at 40' 1/2 sacks hulls and 10 sacks cement.

(If additional description is necessary, use BACK of this sheet)

3-22-52

Name of Plugging Contractor Anschutz Drilling Co., Inc.  
Address 709 Union National Bank Bldg., Wichita, Kansas

STATE OF Kansas, COUNTY OF Sedgwick, ss.  
Leon L. Mehler (employee of owner) or (owner or operator) of the above-described well, being first duly sworn on oath, says: That I have knowledge of the facts, statements, and matters herein contained and the log of the above-described well as filed and that the same are true and correct. So help me God.

(Signature) Leon L. Mehler  
709 Union Nat'l. Bank Bldg.  
(Address)

SUBSCRIBED AND SWORN to before me this 19th day of March, 1952

Guilma V. Shipman  
Notary Public

My commission expires May 24, 1952

23-8390-s 6-51-20M

PLUGGING  
FILE SEC 18 T 8 R 21  
BOOK PAGE 3 LINE 7

DRILLER'S LOG

TAXMAN OIL COMPANY  
 #1 Louise Calhoun  
 SW SW SE 18-85-21W  
 Graham County, Kansas

FROM	TO		ELEVATION: 2056 D.F.
0	85	Shale, Sand and Clay	TOPS:
85	155	Shale and GIP Rock	Heebner 3254
155	605	Shale	Toronto 3276
605	950	Sand and Shale	Lansing 3294
950	1150	Shale	Congl. 3608
1150	1360	Sand	Arb. 3644
1360	1630	Red Bed and Shale and Shells	
1630	1675	Anhydrite	COMMENCED: 3-8-52
1675	1900	Shale	COMPLETED: 3-17-52
1900	2105	Shale and Shells	
2105	2260	Shale and Lime	CASING RECORD:
2260	2370	Shale and Shells	8-5/8" set at 193' with
2370	2685	Lime and Shale	150 sacks cement and
2685	2780	Shale and Shells	200# calcium chloride
2780	2975	Shale and Lime Streaks	
2975	3045	Shale and Shells	
3045	3355	Lime and Shale	
3355	3408	Lime	
3408	3460	Lime and Shale	
3460	3520	Lime	
3520	3608	Shale and Lime	
3608	3644	Conglomerate	
3644	3660	Arbuckle	
3660		Total Depth	

322-52

STATE OF KANSAS )  
 )  
 COUNTY OF SEDGWICK )

I hereby affirm that the above and foregoing is a true and correct copy of the log of Taxman Oil Company's #1 Louise Calhoun, located SW SW SE Section 18-85-21W, Graham County, Kansas.

ANSCHUTZ DRILLING CO., INC.

By: *Leon L. Mehler*  
 Leon L. Mehler

Subscribed and sworn to before me this 19th day of March, 1952.

My Commission Expires: May 24, 1952

*Wilma V. Hubman*  
 Notary Public

**PLUGGING**  
 FILE SEC 17 T. 2 R. 21  
 BOOK PAGE 3 LINE 7