

15-065-21769-00-00


STATE OF KANSAS
STATE CORPORATION COMMISSION

WELL PLUGGING RECORD

Give All Information Completely
Make Required Affidavit
Mail or Deliver Report to
Conservation Division
State Corporation Comm.
245 North Water
Wichita, KS 67202

Graham County. Sec. 18 Twp. 8S Rge. 21W E/W
Location as "NE/CNW $\frac{1}{4}$ /SW $\frac{1}{4}$ " or footage from lines
660FNL 330FWL NW/4

Lease Owner Vicorp Energy Inc.
Lease Name Davignon Well No. 001
Office Address 1777 S. Harrison, Denver, Colorado 80210
Character of Well (Completed as Oil, Gas or Dry Hole)

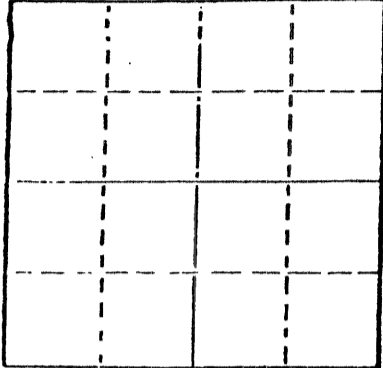

Locate well correctly on above
Section Plat

Dry
Date Well completed 3-6 1983
Application for plugging filed 3-5 1983
Application for plugging approved 3-5 1983
Plugging commenced 3-6 1983
Plugging completed 3-6 1983
Reason for abandonment of well or producing formation

Dry
If a producing well is abandoned, date of last production 19

Was permission obtained from the Conservation Division or
its agents before plugging was commenced? Yes
Baltzor

Name of Conservation Agent who supervised plugging of this well
Producing formation Depth to top Bottom Total Depth of Well 3700
Show depth and thickness of all water, oil and gas formations.

OIL, GAS OR WATER RECORDS

CASING RECORD

FORMATION	CONTENT	FROM	TO	SIZE	PUT IN	PULLED OUT
		0	289	8 5/8		

Describe in detail the manner in which the well was plugged, indicating where the mud fluid
was placed and the method or methods used in introducing it into the hold. If cement or other
plugs were used, state the character of same and depth placed, from feet to
feet for each plug set.

Plugged:
20 sacks @ 1591
100 sacks @ 800
40 sacks @ 280
Bridge plug @ 40 with sacks to cellar
10 sacks in rathole; 10 sacks in mousehole
Completed 4:30 AM 3-6-83
Sun Cementing

(If additional description is necessary, use BACK of this sheet)

Name of Plugging Contractor DaMac Drilling Inc.

STATE OF Kansas COUNTY OF Barton, ss.


Carol A. Efthim (employee of owner) or (owner or operator)
of the above-described well, being first duly sworn on oath, says: That I have knowledge of
the facts, statements, and matters herein contained and the log of the above-described well
as filed and that the same are true and correct. So help me God.

(Signature) Carol A. Efthim
Box 1164, Great Bend, KS 67530
(Address)

SUBSCRIBED AND SWORN TO before me this 6th day of March, 1983

Vada I. Sullivan
Notary Public.

My commission expires Jan. 30, 1984

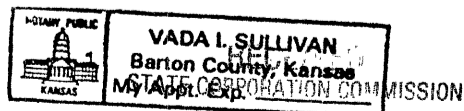

JUN 06 1983

6-6-83
CONSERVATION DIVISION
Wichita, Kansas

WELL LOG

15-065-21769-00-00

COMPANY Vicorp Energy Inc.

SEC. 18 T. 8S R. 21W

FARM Davignon

NO. 001

LOC. 660FNL 330FWL NW/4


TOTAL DEPTH 3700 RTD

COUNTY Graham, Ks.

COMM. 2-28-83

COMP. 3-6-83

CONTRACTOR DaMac Drilling Inc.

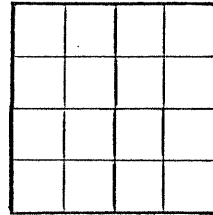

CASING 8 5/8 set @ 289'

ELEVATION

PRODUCTION P & A


FIGURES INDICATE BOTTOM OF FORMATIONS

Clay, Sand	0	287
Sand, RedBed	287	1100
Cedar Hill Sand	1100	1318
RedBed, Sand	1318	1993
Anhy	1591	1626
Shale	1993	2255
Lime, Shale	2255	3700 RTD

State of Kansas }
County of Barton } SS

I, Carol A. Efthim of DaMac Drilling

upon oath state the above and foregoing is a true and correct copy of the log of the Davignon # 001 well.

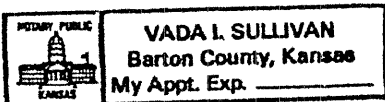

Carol A. Efthim RECEIVED
STATE CORPORATION COMMISSION

Subscribed and sworn to before me this 6th day of March 19 83

JUN 06 1983

My Commission Expires: Jan. 30, 1984

Vada I. Sullivan
NOTARY PUBLIC
CONSERVATION DIVISION
Wichita, Kansas