


15-065-00355-00-00

WELL PLUGGING RECORD

Give All Information Completely  
Make Required Affidavit  
Mail or Deliver Report to:  
Conservation Division  
State Corporation Commission  
800 Biting Building  
Wichita, Kansas

NORTH

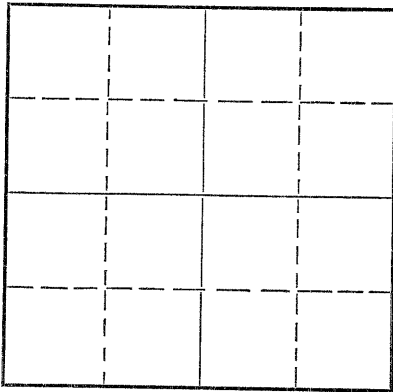

Locate well correctly on above  
Section Plat

Graham County. Sec. 34 Twp. 8 Rge. 21W (E) (W)  
Location as "NE/CNW $\frac{1}{4}$ SW $\frac{1}{4}$ " or footage from lines SW SW SW  
Lease Owner Veeder Supply & Development Company, et al  
Lease Name Guilleaume Well No. 1  
Office Address Cherryvale, Kansas  
Character of Well (completed as Oil, Gas or Dry Hole) Dry Hole  
Date well completed 11-21 19 52  
Application for plugging filed 11-22 19 52  
Application for plugging approved 11-22 19 52  
Plugging commenced 11-22 19 52  
Plugging completed 11-23 19 52  
Reason for abandonment of well or producing formation Dry Hole

If a producing well is abandoned, date of last production \_\_\_\_\_ 19\_\_\_\_  
Was permission obtained from the Conservation Division or its agents before plugging was commenced? Yes

Name of Conservation Agent who supervised plugging of this well Eldon Petty, Hayes, Kansas  
Producing formation \_\_\_\_\_ Depth to top \_\_\_\_\_ Bottom \_\_\_\_\_ Total Depth of Well 2750 Feet  
Show depth and thickness of all water, oil and gas formations.

OIL, GAS OR WATER RECORDS

CASING RECORD

Formation	Content	From	To	Size	Put In	Pulled Out
				8 5/8	217	Cemented

Describe in detail the manner in which the well was plugged, indicating where the mud fluid was placed and the method or methods used in introducing it into the hole. If cement or other plugs were used, state the character of same and depth placed, from \_\_\_\_\_ feet to \_\_\_\_\_ feet for each plug set.

Mud 3750 to 200 feet rock and plugged 200'. 15 sacks cement  
200 ft to 35 ft. rock and mud 1/2 sack hulls - 10 sacks cement 35 ft. to surface.

RECEIVED  
STATE CORPORATION COMMISSION

COMMISSIONER

Name of Plugging Contractor Veeder Supply & Development Company  
Address P. O. Box 201, Cherryvale, Kansas

11-28-52

STATE OF Kansas, COUNTY OF Montgomery, ss.  
Floyd Hild (employee of owner) or (owner or operator)

being first duly sworn on oath, says: That I have knowledge of the facts, statements, and matters herein contained and the log of the above-described well as filed and that the same are true and correct. So help me God.

(Signature) Floyd Hild  
Cherryvale, Kansas (Address)

SUBSCRIBED AND SWORN to before me this 26th day of November, 19 52

My commission expires July 11, 1956

Loles Lawson  
Notary Public.

PLUGGING  
FILE SEC 34 T 8 R 2124  
BOOK PAGE 62 LINE 13

15-065-00355-00-00

Company John T. Crane-Phillips Petroleum Co.

Sec. 34 T. 8S R. 21W

Loc. SW SW SW

Farm Quilleanne

No. 1

County Graham

Total Depth 3751

Comm. 10-29-52

Comp. 11-10-52

Shot or Treated

Contractor Veeder Supply & Development Co.

Issued Set 216' of 8 5/8" Casing  
Cemented with 125 sacks cement.


Casing	
20 in.	10 in
15 1/2	8 1/4
12 1/2	6 5/8
13 3/8	5 3/16

Elevation

Production

Figures Indicate Bottom of Formation

Cellar	0	6	6
Soil Clay	6	30	24
Shale	30	135	105
Sand	135	160	25
Shale	160	560	400
Shells Shale	560	890	330
Sand Shale	890	1025	135
Shale Shells	1025	1140	115
Sand	1140	1365	225
Red Bed	1365	1620	255
Anhydrite	1620	1655	35
Shale Lime Shells	1655	2475	820
Shale Lime	2475	2569	184
Lime	2569	2765	106
Lime Shale	2765	3240	475
Lime	3240	3595	355
Lime Shale	3595	3691	96
Lime	3691	3751	60

Run 3750' of 8 5/8" Casing  
Cemented with 100 sacks cement.

RECEIVED  
OIL AND GAS COMMISSION  
NOV 23 1952  
CONSERVATION DIVISION  
Wichita, Kansas

**PLUGGING**  
FILE SEC 34 T 8 R 21W  
BOOK PAGE 62 LINE 13

11-28-52