

WELL PLUGGING RECORD

Give All Information Completely
Make Required Affidavit
Mail or Deliver Report to
Conservation Division
State Corporation Comm.
200 Colorado Derby Bldg.
202 W. 1st St.
Wichita, KS 67202

Graham County Sec. 34 Twp. 8s Rge. 21W
Location as "NE/CNW/SW" or footage from lines
SE NW SE

Lease Owner D & A Oil
Lease Name Talbert "B" Well No. # 1
Office Address Box 94 Damar, Ks 67632

Character of Well (Completed as Oil, Gas or Dry Hole) Dry Hole


Date Well completed 10-10 1983
Application for plugging filed 10-09 1983
Application for plugging approved 10-09 1983
Plugging commenced 10:50 P.M. 10-09 1983
Plugging completed 2:00 A.M. 10-10 1983

Reason for abandonment of well or producing formation No Commercial Production

If a producing well is abandoned, date of last production 19

Was permission obtained from the Conservation Division or its agents before plugging was commenced? Yes

Name of Conservation Agent who supervised plugging of this well Gil Balthazor
Producing formation _____ Depth to top _____ Bottom _____ Tl. Depth of Well _____
Show depth and thickness of all water, oil and gas formations.

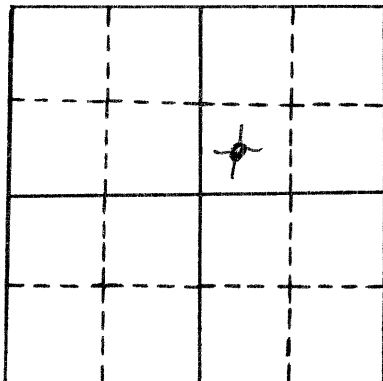

locate well correctly
on above
Section Plot

OIL, GAS OR WATER RECORDS

CASING RECORD

FORMATION	CONTENT	FROM	TO	SIZE	PUT IN	PULLED OUT
Surface Casing	60-40pos	0'	256'	8 5/8"	256'	0'

Describe in detail the manner in which the well was plugged, indicating where the mud fluid was placed and the method or methods used in introducing it into the hold. If cement or other plugs were used, state the character of same and depth placed, from _____ feet to _____ feet for each plug set.


Plug #1 3660' with 20sxs
Plug #2 1620' with 20sxs
Plug #3 930' with 100sxs
Plug #4 270' with 40sxs
Plug #5 40' with 10sxs
Total _____ 10sxs in rathole
_____ 200sxs 50-50pos 6%gel 3%cc
P.D.@ 2:00 A.M. 10-09-83

(If additional description is necessary, use BACK of this sheet)

Name of Plugging Contractor Pioneer Drilling Company, Inc.
308 West Mill Plainville, KS 67663

STATE OF Kansas COUNTY OF Graham, ss.

Antionette Hamel (employee of owner) or (owner or operator) of the above described well, being first duly sworn on oath, says: That I have knowledge of the facts, statements, and matters herein contained and the log of the above described well is filed and that the same are true and correct. So help me God.

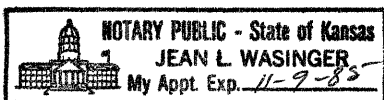

REC'D 10-26-83 (Signature) Antionette Hamel
(Address) Box 94, Damar, Ks. 67632

SUBSCRIBED AND SWORN TO before me this 21st day of October, 19 83

My commission expires 11-9-85

Jean L. Wasinger
Notary Public