

STATE OF KANSAS
STATE CORPORATION COMMISSION

WELL PLUGGING RECORD

Give All Information Completely
Make Required Affidavit
Mail or Deliver Report to:
Conservation Division
State Corporation Commission
800 Bitting Building
Wichita, Kansas

Graham County. Sec. 12 Twp. 9 Rge. 21W (E) (W)

Location as "NE/CNW/SW" or footage from lines SW SW NW

Lease Owner Nadel and Gussman

Lease Name Morin Well No. 1

Office Address Box 309, Tulsa, Oklahoma

Character of Well (completed as Oil, Gas or Dry Hole) Dry

Date well completed 4-25-1952

Application for plugging filed 4-25-1952

Application for plugging approved 4-25-1952


Plugging commenced 4-25-1952

Plugging completed 4-25-1952

Reason for abandonment of well or producing formation Dry

If a producing well is abandoned, date of last production 19

Was permission obtained from the Conservation Division or its agents before plugging was commenced? Yes

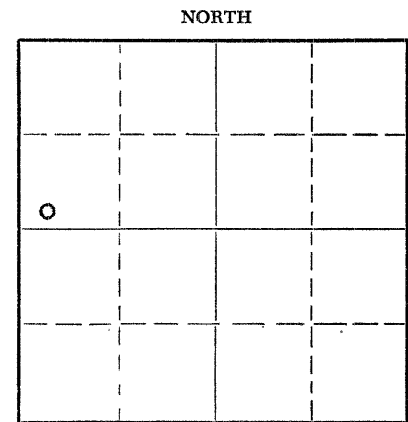

Locate well correctly on above Section Plat

Name of Conservation Agent who supervised plugging of this well Eldon Petty

Producing formation _____ Depth to top _____ Bottom _____ Total Depth of Well 3780 Feet

Show depth and thickness of all water, oil and gas formations.

OIL, GAS OR WATER RECORDS

CASING RECORD

FORMATION	CONTENT	FROM	TO	SIZE	PUT IN	PULLED OUT
				8-5/8"	149 ZAP 1000	0

Describe in detail the manner in which the well was plugged, indicating where the mud fluid was placed and the method or methods used in introducing it into the hole. If cement or other plugs were used, state the character of same and depth placed, from _____ feet to _____ feet for each plug set.

Filled hole with heavy mud 3780 to 140' - set plug at 135' with 15 sacks cement - filled with mud to 45' - set plug at 40' with 10 sacks cement.

RECEIVED
STATE CORPORATION COMMISSION
5/1/52
MAY - 1 1952
CONSERVATION DIVISION
Wichita, Kansas

(If additional description is necessary, use BACK of this sheet)
Name of Plugging Contractor Reserve Drilling Company, Inc.
Address 703 Union National Bank Building, Wichita 2, Kansas

STATE OF KANSAS, COUNTY OF SEDGWICK, ss.
L. C. Hay (employee of owner) of the above-described well, being first duly sworn on oath, says: That I have knowledge of the facts, statements, and matters herein contained and the log of the above-described well as filed and that the same are true and correct. So help me God.

(Signature) L. C. Hay
703 Union National Bank Bldg. Wichita
(Address)

SUBSCRIBED AND SWORN TO before me this 29th day of April, 1952

Rola Bandy
Notary Public.

My commission expires Nov. 3, 1952

PLUGGING
FILE SEC 12 9 24
BOOK PAGE 12 LINE 9

WELL LOG

KADEL AND GUSSMAN

MORIN WELL No. 1

SW SW NW 12-9-21W
Graham County, Kansas

Comm: 4-15-52
Comp: 4-25-52

Casing: 8-5/8" 149' w/100 Sax

Formations	Depth	Geological Tops	
Rock and shale	149		
Shale	240		
Shale, sand and shells	1450		
Shale and shells	1679		
Anhydrite	1718	Heebner Shale	3377
Shale and shells	2220	Toronto Lime	3402
Broken lime and shale	2545	Lansing-Kansas City	3417
Lime and shale	2720	Base Kansas City	3632
Lime, shale and shells	2830	Conglomerate (Shale)	3711
Shale and lime	3434	Arbuckle	3733
Lime	3606		
Lime and shale	3702		
Lime, shale and Conglomerate	3739		
Lime	3741		
Arbuckle	3780		

STATE OF KANSAS)
COUNTY OF SEDGWICK) SS:

L. C. Hay, of lawful age, deposes and states that the above formations and depths are correct as shown by the daily drilling log of the Morin Well No. 1 in the SW NW 12-9-21W, Graham County, Kansas.

Subscribed and sworn to before me this 29th day of April, 1952.

PLUGGING
FILE SEC. 121 9 R 2W
CONSERVATION
BOOK PAGE 1119

L. C. Hay
Notary Public

My commission expires Nov. 3, 1952