


STATE OF KANSAS
STATE CORPORATION COMMISSION

Give All Information Completely
Make Required Affidavit
Mail or Deliver Report to:
Conservation Division
State Corporation Commission
800 Biffing Building
Wichita, Kansas

WELL PLUGGING RECORD

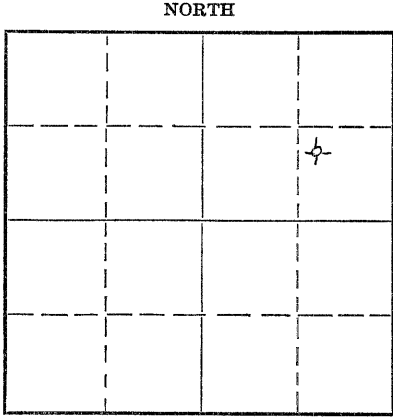

Locate well correctly on above
Section Plat

Graham County. Sec. 14 Twp. 9S Rge. (E) 21(W)
Location as "NE/CNW $\frac{1}{4}$ SW $\frac{1}{4}$ " or footage from lines 990' WEL. & 990' NSL. of NE/4
Lease Owner Gulf Oil Corporation
Lease Name R. Balthazor Well No. 4
Office Address Box 661, Tulsa 2, Oklahoma
Character of Well (completed as Oil, Gas or Dry Hole) Dry Hole
Date well completed March 11 19 52
Application for plugging filed (Verbally) March 11 19 52
Application for plugging approved (Verbally) March 11 19 52
Plugging commenced March 11 19 52
Plugging completed March 12 19 52
Reason for abandonment of well or producing formation Dry Hole

If a producing well is abandoned, date of last production _____ 19____
Was permission obtained from the Conservation Division or its agents before plugging was commenced? Yes

Name of Conservation Agent who supervised plugging of this well Mr. Eldon Petty
Producing formation Arbuckle Depth to top 3751' Bottom 3782' Total Depth of Well 3782 Feet
Show depth and thickness of all water, oil and gas formations.

OIL, GAS OR WATER RECORDS

CASING RECORD

Formation	Content	From	To	Size	Put In	Pulled Out
				8-5/8"	204'	0'

Describe in detail the manner in which the well was plugged, indicating where the mud fluid was placed and the method or methods used in introducing it into the hole. If cement or other plugs were used, state the character of same and depth placed, from _____ feet to _____ feet for each plug set.

Spotted 15 sacks of cement through drill pipe on plug at 200'; pushed plug to 40' and spotted 15 sacks of cement on plug to surface.

(If additional description is necessary, use BACK of this sheet)

Name of Plugging Contractor Glenn W. Peel
Address Box 359, Hoisington, Kansas

STATE OF Kansas, COUNTY OF Rice, ss.
H. H. Wright (employee of owner) or (owner or operator) of the above-described well,
being first duly sworn on oath, says: That I have knowledge of the facts, statements, and matters herein contained and the log of the above-described well as filed and that the same are true and correct. So help me God.

(Signature) [Signature]
Box 544, Chase, Kansas (Address)

SUBSCRIBED AND SWORN to before me this 17th day of March, 19 52

My commission expires April 14, 1952 [Signature] Notary Public.

28-8390-s 6-51-20M

PLUGGING
FILE SEC 14 T 9 R 21(W)
BOOK PAGE 1 LINE 22

3/18/52
MAR 18 1952

WELL NO. **4** LEASE **Rosa Balthazor** COMPANY **Gulf Oil Corporation** A.F.E. **2839**
 DATE—DRILLING BEGAN **2-25-52** **plugging** WELL COMPLETED **3-11-52** FIRST PRODUCTION —
 SAND RECORD **Arbuckle 3751'** TOTAL DEPTH **3782'**
 INITIAL PRODUCTION **Dry Hole plugged and abandoned**

CASING RECORD

SIZE	WEIGHT	THD.	CLASS	MAKE	SET AT DEPTH	SACKS CEMENT	LBS. CAL. CHLO.	PULLED	LEFT IN
8-5/8"	32	10V	C-1	Smls	213'	125	200		213'

S- 14 T- 9S R- 21W

Center				
NE				
SE			o	
NW				
Graham County, Kansas				

Distance H: 9'

ELEVATION— DF 2202'

FORMATION RECORD

	FROM	TO:
Clay & shale	0'	35
Sand		65
Shale & sand shale		150
sand & water		870
shale & sand stks		910
shale & sandstone		1135
shale		1445
Anhydrite		1665
shale		1710
shale & shells		1815
sand & shale		1980
shale		2030
broken lime & shale		2160
lime & shale		2430
shale & lime stks		2750
shale & lime		3045
lime		3315
lime & shale		3380
lime		3445
lime & shale		3685
lime		3720
Arbuckle		3757
Dolomite		3782
Total Depth		3782

19 9 21W
BOOK PAGE 1 LINE 22

CONSERVATION DIVISION
Wichita, Kansas

DRILLER'S

LOG

Company: Gulf Oil Corp.

NW 34 NE

Sec. 14, Twp. 9, Rge. 21,

Farm: Balthazor Well No. 4
 Comm: 2-25-52 Comp: 3-12-52

County: Rocks,
 Kansas

Total Depth: 3782'
 Contractor: Peel Brothers, Inc.

Elevation:

Casing: 8 5/8" @ 212' cem.

Production: Dry

Figures below indicate bottom of formations

Clay and Shale	0'	35
Sand		65
Shale and Sand		150
Shale		870
Sand and Water		910
Shale and Sand Streaks		1135
Shale and Sandstone		1445
Shale		1665
Anhydrite		1710
Shale		1815
Shale and Shells		1980
Sand and Shale		2030
Shale		2160
Broken Lime and Shale		2430
Lime and Shale		2750
Shale and Lime Streaks		3045
Shale and Lime		3315
Lime		3380
Lime and Shale		3445
Lime		3685
Lime and Shale		3720
Lime		3757
Arbuckle		3782
Dolomite		3782
Total Depth		3782

This is to certify that the above information is to the best of my knowledge true and correct.

PEEL BROTHERS, INC.,

BY: R. B. Sutton

SUBSCRIBED AND SWORN to before me this 12th day of March, 1952.

Bernice L. Lewis
 Notary Public - Barton County, Mo.

My commission expires: April 23, 1955.