

D-10440

FORM CP-4

15-065-1932-00-01


STATE OF KANSAS
STATE CORPORATION COMMISSION

WELL PLUGGING RECORD

Give All Information Completely
Make Required Affidavit
Mail or Deliver Report to
Conservation Division
State Corporation Comm.
245 North Water
Wichita, KS 67202

Graham County. Sec. 15 Twp. 9 Rge. 21 E/W
Location as "NE/CNW $\frac{1}{4}$ SW $\frac{1}{4}$ " or footage from lines
C SE SW

Lease Owner Sohio Petroleum Company
Lease Name Benson Well No. 2
Office Address Box 673, Russell, KS 67665
Character of Well (Completed as Oil, Gas or Dry Hole) SWD

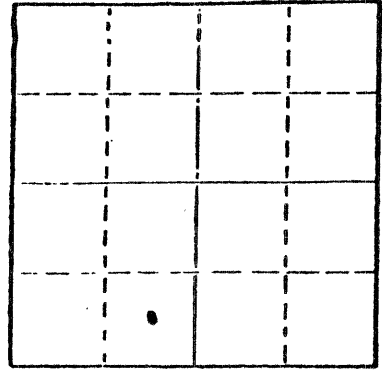

Locate well correctly on above Section Plat

Date Well completed June 13 1943
Application for plugging filed August 19 1977
Application for plugging approved August 23 1977
Plugging commenced August 30 1977
Plugging completed September 9 1977
Reason for abandonment of well or producing formation
Disposal well with no future value to lease, down hole problem
If a producing well is abandoned, date of last production 19

Was permission obtained from the Conservation Division or its agents before plugging was commenced? Yes

Name of Conservation Agent who supervised plugging of this well Gilbert Balthazor
Producing formation _____ Depth to top _____ Bottom _____ Total Depth of Well 3873'
Show depth and thickness of all water, oil and gas formations.

OIL, GAS OR WATER RECORDS

CASING RECORD

FORMATION	CONTENT	FROM	TO	SIZE	PUT IN	PULLED OUT
				8 5/8"	267'	None
				5 1/2"	3762'	None
			(Liner)	4 1/2"	3723-3821'	None
			(Tubing)	3 1/2"	3683'	329'

Describe in detail the manner in which the well was plugged, indicating where the mud fluid was placed and the method or methods used in introducing it into the hold. If cement or other plugs were used, state the character of same and depth placed, from _____ feet to _____ feet for each plug set.

Pulled 329' of 3 1/2" tubing. Unsuccessful attempt to pull 5 1/2", none recovered.
Rig up Howco, tied onto 5 1/2" casing, mixed 200 sx of 50-50 Poz, 2% Gel, pumped in 5 1/2" casing at 2 BPM at 400#, well on immediate vacuum. Shut down 19 min, started mixing second 200 sx, pumped in at 300# at 2 BPM, in 32 min pressure increased to 1000#. Shut well in w/1000#. No blow on annulus, tied in to 8 5/8" - 5 1/2" annulus, mixed 200 sx cement, pumped in annulus at 400#, shut in at 2:14 PM, 9-9-77. Plugger on location. Well P&A 9-9-77.

9/20/77

(If additional description is necessary, use BACK of this sheet)

Name of Plugging Contractor Kelso Casing Pulling
Chase, Kansas

STATE OF KANSAS COUNTY OF RUSSELL, ss.
W. H. Ward (employee of owner) or (owner or operator)


of the above-described well, being first duly sworn on oath, says: That I have knowledge of the facts, statements, and matters herein contained and the log of the above-described well as filed and that the same are true and correct. So help me God.

(Signature) W. H. Ward
Box 673, Russell, KS 67665
(Address)

SUBSCRIBED AND SWORN TO before me this 19th day of September, 1977

My appointment expires 9-28-79

Juanita Valentine
Notary Public.

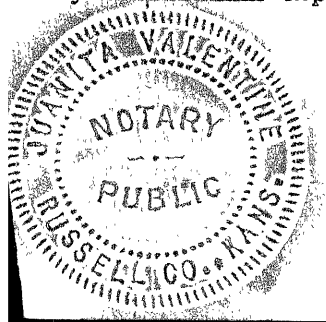

N. Appleman Co.
Benson #2

Sec. 15 Twp. 9 Rge. 21
Graham County, Kansas

D-10440

Total Depth: 3775'
Comm: 5/25/43 Comp: 6/13/43

Casing
13 jts. 8 5/8" Set at 267'
124 jts. 5" Set at 3762'

Cement
110 Sacks
100 Sacks

Formation	Depth	Formation	Depth
Clay & Sand	282'	Shale	2904
Shale & Shells	400	Lime Shale	2960
Sandy Shale	510	Shale & Shells	3400
Shale & Shells	550	Lime	3536
Shale	650	Cherty Lime	3545
Sandy Shale	690	Lime & Shale	3550
Sticky Shale	700	Lime	3775
Shale & Shells	710		
Sand	775		
Shale & Shells	1170		
Sand Shale & Shells	1640		
Shale-Red Rock	1740		
Anhydrite	1795		
Shale Lime	1900		
Shale Lime Shells	2225		
Lime Shells	2340		
Lime & Shale	2420		
Lime Shale Shells	2565		
Lime Shale	2701		
Shale Shells	2865		

RECEIVED
STATE CORPORATION COMMISSION

AUG 23 1977

CONSERVATION DIVISION
Wichita, Kansas

State of Kansas)
) SS
Russell County)

I hereby certify that the above information is true and correct to the best of my knowledge.

Original signed by C. L. Roberts

B & R DRILLING COMPANY

Subscribed and sworn to before me this day, _____ of June, 1943.

Notary Public