

STATE OF KANSAS
STATE CORPORATION COMMISSION


Form CP-4

Give All Information Completely
Make Required Affidavit
Mail or Deliver Report to:
Conservation Division
State Corporation Commission
P. O. Box 17027
Wichita, Kansas 67217
NORTH

WELL PLUGGING RECORD

Graham County, Sec. 18 Twp. 9S Rge. (E) 21 (W)
Location as "NE/CNW*SW*" or footage from lines. SE NE NE

Lease Owner Cities Service Oil Company
Lease Name Seefeld "A" Well No. 5
Office Address Box 553 Russell, Kansas 67665
Character of Well (completed as Oil, Gas or Dry Hole) Oil
Date well completed 11-1 19 50
Application for plugging filed 12-1 19 71
Application for plugging approved 12-2 19 71
Plugging commenced 12-9 19 71
Plugging completed 12-15 19 71
Reason for abandonment of well or producing formation Depleted

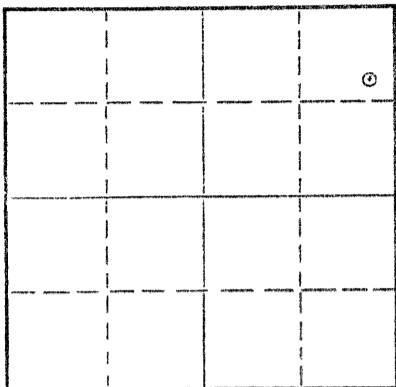

Locate well correctly on above
Section Flat

If a producing well is abandoned, date of last production September 1970
Was permission obtained from the Conservation Division or its agents before plugging was commenced? Yes

Name of Conservation Agent who supervised plugging of this well Mr. W. L. Nichols
Producing formation Arbuckle Depth to top 3778' Bottom 6' Pen. Total Depth of Well 3784 Feet
Show depth and thickness of all water, oil and gas formations.

OIL, GAS OR WATER RECORDS

CASING RECORD

FORMATION	CONTENT	FROM	TO	SIZE	PUT IN	PULLED OUT
				8 5/8"	240'	None
				5 1/2"	3779'	314'

Describe in detail the manner in which the well was plugged, indicating where the mud fluid was placed and the method or methods used in introducing it into the hole. If cement or other plugs were used, state the character of same and depth placed, from _____ feet to _____ feet for each plug set.

Checked bottom, ran sand to 3760' and dumped in 5 sx. cement. Shot 5 1/2" casing at 814', 716', 619', 436', and 314' and pulled 10 joints. Pumped in 5 sx. hulls, 18 sx. gel, 110 cu. ft. cement, 8 sx. gel and 30 cu. ft. cement 4 sx. gel and 10 sx. cement to surface.

RECEIVED
STATE CORPORATION COMMISSION
4-13-72
APR 13 1972
CONSERVATION DIVISION
Wichita, Kansas

(If additional description is necessary, use BACK of this sheet)
Name of Plugging Contractor Knight Casing Pulling Co., Inc.
Address Chase, Kansas

STATE OF Kansas, COUNTY OF Russell, ss.
E. W. Peterman (employee of owner) or (owner or operator) of the above-described well, being first duly sworn on oath, says: That I have knowledge of the facts, statements, and matters herein contained and the log of the above-described well as filed and that the same are true and correct. So help me God.

(Signature) *E. W. Peterman*
Box 553 Russell, Kansas 67665 (Address)

Subscribed and sworn to before me this 12th day of April, 1972

My commission expires 10-5-72
James F. Kyger Notary Public



WELL RECORD

Company Cities Service Oil Co. Well No. 5 Farm Seefeld
 Location 990' South and 330' West of NE Cor. Sec. 18 T. 9 R. 21W
 Elevation 2269 (2267 Cr.) County Graham State Kansas
 Drg. Comm. October 18, 1950 Contractor R. W. Rine Drilling Company
 Drg. Comp. November 1, 1950 Acid None
 T. D. 3784' Initial Prod. Draw-down potential: 3000 oil, no water, 2 1/2 hrs. (12-4-50)
 (Ind. capacity 3468 bbls. per day)

CASING RECORD:

8-5/8" @ 240' cem. 175 sx cement
 5-1/2" @ 3779' cem. 175 sx

FORMATION RECORD:

surface clay & lime	0-240
shale, sand & shells	1765
anhydrite	1800
shale & shells	2070
shale, shells & lime	3100
lime & shale	3335
lime	3770
shale & chert	3774
sand	3776
lime	3778
lime	3778 RTD = 3780 SLM
lime	3784 T. D.

Corr. Lansing	3474' (-1207)
Corr. Cherty Conglomerate	3753'
Corr. Arbuckle	3778' (-1511)
Penetration	6'
Total Depth	3784' (-1517)

Fillup:

70' oil in 15 mins. at 3781
 100' oil in 40 mins. at 3781
 1600' oil in 1 hr. 40 mins. at 3784
 2134' oil in 2 hrs. 10 mins. at 3784
 2466' oil in 2 hrs. 40 mins. at 3784
 2810' oil in 4 hrs. 40 mins. at 3784

SYFO: 500' 0°
 1000' 0°
 1500' 0°
 2000' 1°
 2500' 1°
 3000' 0°

7-7/8" rotary hole.

RECEIVED
 STATE CORPORATION COMMISSION
 DEC 2 1971
 CONSERVATION DIVISION
 Wichita, Kansas