

STATE OF KANSAS
STATE CORPORATION COMMISSION

WELL PLUGGING RECORD

Give All Information Completely
Make Required Affidavit
Mail or Deliver Report to
Conservation Division
State Corporation Comm.
245 North Water
Wichita, KS 67202

Graham County. Sec. 18 Twp. 9S Rge. 21 E/W
Location as "NE/CNW $\frac{1}{4}$ SW $\frac{1}{4}$ " or footage from lines
SE SE SW


Lease Owner Murfin Drilling Company
Lease Name Forgy Well No. 1
Office Address 250 N. Water, Suite 300; Wichita, KS 67202
Character of Well (Completed as Oil, Gas or Dry Hole) _____
Oil

Date Well completed 10/30 1950
Application for plugging filed --- 19
Application for plugging approved verbal 9
Plugging commenced 8/23 1984
Plugging completed 8/23 1984
Reason for abandonment of well or producing formation _____
uneconomical

If a producing well is abandoned, date of last production
Feb. 1973

Was permission obtained from the Conservation Division or
its agents before plugging was commenced? yes

Name of Conservation Agent who supervised plugging of this well Carl Goodrow
Producing formation Arbuckle Depth to top 3852' Bottom 3859' Total Depth of Well 3859'
Show depth and thickness of all water, oil and gas formations.

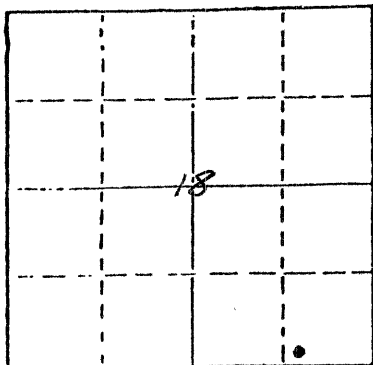

Locate well correctly on above
Section Plat

OIL, GAS OR WATER RECORDS

CASING RECORD

FORMATION	CONTENT	FROM	TO	SIZE	PUT IN	PULLED OUT
				8 5/8"	161'	--
				5 1/2"	3853'	--

Describe in detail the manner in which the well was plugged, indicating where the mud fluid
was placed and the method or methods used in introducing it into the hold. If cement or other
plugs were used, state the character of same and depth placed, from _____ feet to
_____ feet for each plug set.


Mixed and pumped down 5 1/2" casing: 50 sx. cement w/2 sx. gel and 3 sx. hulls,
followed by 10 sx. cement w/15 sx. gel, followed by 7 sx. gel. Released plug
and pumped 90 sx. cement at 500# max. press. Pumped 50 sx. cement down 8 5/8"
and 5 1/2" annulus at 150# max. press.

(If additional description is necessary, use BACK of this sheet)

Name of Plugging Contractor Murfin Drilling Company

STATE OF Kansas COUNTY OF Sedgwick, ss.
P. T. Canaday, Jr. Engineer (employee of owner) or (owner or operator)
of the above-described well, being first duly sworn on oath, says: That I have knowledge of
the facts, statements, and matters herein contained and the log of the above-described well
as filed and that the same are true and correct. So help me God.

(Signature) By: [Signature]
250 N. Water, Suite 300; Wichita, KS 67202
(Address)

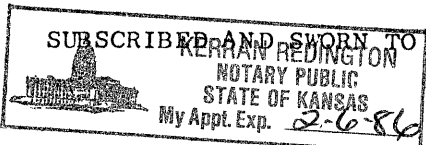

My commission expires 2/6/86

Kerran Redington
Notary Public.

RECEIVED
STATE CORPORATION COMMISSION

SEP 17 1984
9-17-84
CONSERVATION DIVISION
Wichita, Kansas