

Give All Information Completely
Make Required Affidavit
Mail or Deliver Report to:
Conservation Division
State Corporation Commission
211 No. Broadway
Wichita, Kansas

WELL PLUGGING RECORD

GRAHAM County, Sec. 13 Twp. 9 Rge. 21 (X) W (W)

Location as "NE/CNW/SW" or footage from lines S 1/2 S 1/2 NE

Lease Owner DANE G HANSEN EST.

Lease Name EICHMAN #9 Well No.

Office Address P O BOX 187, LOGAN, KANSAS

Character of Well (completed as Oil, Gas or Dry Hole) DRY HOLE

Date well completed JUNE 2, 1967 19

Application for plugging filed JUNE 1, 1967 19

Application for plugging approved JUNE 1, 1967 19


Plugging commenced JUNE 1, 1967 19

Plugging completed JUNE 2, 1967 19

Reason for abandonment of well or producing formation TOO LOW STRUCTURALLY

If a producing well is abandoned, date of last production 19

Was permission obtained from the Conservation Division or its agents before plugging was commenced? YES

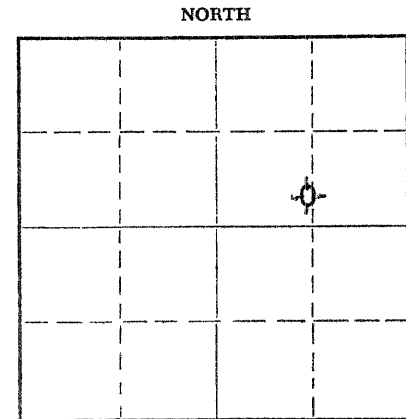

Locate well correctly on above Section Plat

Name of Conservation Agent who supervised plugging of this well W. L. NICHOLS, MORELAND, KANSAS

Producing formation Depth to top Bottom Total Depth of Well 3777 Feet

Show depth and thickness of all water, oil and gas formations.

OIL, GAS OR WATER RECORDS

CASING RECORD

FORMATION	CONTENT	FROM	TO	SIZE	PUT IN	PULLED OUT
				8-5/8"	201.31'	NONE

Describe in detail the manner in which the well was plugged, indicating where the mud fluid was placed and the method or methods used in introducing it into the hole. If cement or other plugs were used, state the character of same and depth placed, from feet to feet for each plug set.

FILLED WITH HEAVY MUD to 540'. SET PLUG. PUT IN 20 SACKS OF CEMENT. FILLED WITH HEAVY MUD TO 210'. SET PLUG. PUT IN 1/2 SACK HULLS & 20 SACKS CEMENT. FILLED WITH HEAVY MUD UP TO 37'. SET PLUG. FILLED TO TOP WITH 1/2 SACK HULLS AND 10 SACKS CEMENT.

RECEIVED
STATE CORPORATION COMMISSION

JUN 9 1967
0-9-67

CONSERVATION DIVISION
Wichita, Kansas

Name of Plugging Contractor C-G DRILLING CO. (If additional description is necessary, use BACK of this sheet)

Address 107 RULE BUILDING, WICHITA, KANSAS 67202

STATE OF KANSAS, COUNTY OF SEDGWICK, ss. G F GALLOWAY (employee of owner) or (owner or operator) of the above-described well, being first duly sworn on oath, says: That I have knowledge of the facts, statements, and matters herein contained and the log of the above-described well as filed and that the same are true and correct. So help me God.

(Signature) G F GALLOWAY 107 RULE BUILDING (Address)

SUBSCRIBED AND SWORN TO before me this 7th day of JUNE, 1967

My commission expires JAN. 23, 1968

PHYLLIS McJIMSEY Notary Public.

W E L L L O G

OPERATOR: DANE G HANSEN ESTATE
WELL NAME: EICHMAN #9 LOCATION: S/2 S/2 NE SEC 13-9-21W
COUNTY: GRAHAM STATE: KANSAS
WELL COMMENCED: MAY 26, 1967 WELL COMPLETED: JUNE 2, 1967
ELEVATION: 2193 KB TOTAL DEPTH: 3777'
PRODUCTION: DRY & ABANDONED RIG NO: #1
CASING - 8-5/8": 201.31' (10 jts) W/135 sacks + 200# CA. CL.
5-1/2": _____

All Measurements taken from the top of rotary bushing.

FROM	TO	FORMATION	DEVIATION FROM VERTICAL	REMARKS:
201	1170	SHALE	525	3/4°
1170	1410	SAND	1000	1°
1410	1684	RED BED SHALE	1500	1 1/2°
1684	1722	ANHYDRITE	2000	1°
1722	2045	SHALE & SHELLS	2500	1°
2045	2225	SHALE & LIME	3000	1/2°
2225	3375	LIME & SHALE	3460	3/4°
3375	3685	LIME		
3685	3750	LIME & SHALE & CHERT		
3750	3777	LIME		


RECEIVED
STATE CORPORATION COMMISSION
JUN 9 1967
CONSERVATION DIVISION
Wichita, Kansas

STATE OF KANSAS)
COUNTY OF SEDGWICK) SS:

The undersigned hereby certifies that to the best of his knowledge and belief, the above facts are true and correct.

C-G DRILLING CO.
By *G F Galloway*
G F GALLOWAY

SUBSCRIBED AND SWORN TO, BEFORE ME, This 7th day of JUNE, 1967.

My comm. exp: Jan. 23, 1968


Phyllis McJimsey
Phyllis McJimsey ---Notary Public