

STATE OF KANSAS  
STATE CORPORATION COMMISSION

WELL PLUGGING RECORD

OR

FORMATION PLUGGING RECORD

Strike out upper line  
when reporting plug-  
ging off formations.

Give All Information Completely  
Make Required Affidavit  
Mail or Deliver Report to:  
Conservation Division  
State Corporation Commission  
800 Bitting Building  
Wichita, Kansas

Graham County, Sec. 16 Twp. 9 Rge. 16/21(W)

Location as "NE1/4NW1/4SW1/4" or footage from lines SE1/4 NE1/4 NW1/4

Lease Owner Barnett Drilling Company, Et Al

Lease Name Boland Well No. 2

Office Address First Nat'l Bank Bldg., Wichita 2, Kansas

Character of Well (completed as Oil, Gas or Dry Hole) Dry Hole

Date well completed July 23 1944

Application for plugging filed July 23 1944

Application for plugging approved July 23 1944


Plugging commenced July 23 1944

Plugging completed July 23 1944

Reason for abandonment of well or producing formation Dry Hole

If a producing well is abandoned, date of last production 19

Was permission obtained from the Conservation Division or its agents before plugging was commenced? Yes

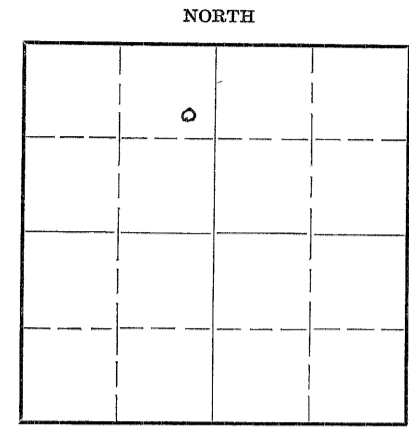

Locate well correctly on above  
Section Plat

Name of Conservation Agent who supervised plugging of this well Eldon R. Petty

Producing formation Depth to top Bottom Total Depth of Well 3792 Feet

Show depth and thickness of all water, oil and gas formations.

OIL, GAS OR WATER RECORDS

CASING RECORD

Formation	Content	From	To	Size	Put In	Pulled Out
				10 3/4	160 ft.	None

Describe in detail the manner in which the well was plugged, indicating where the mud fluid was placed and the method or methods used in introducing it into the hold. If cement or other plugs were used, state the character of same and depth placed, from feet to feet for each plug set.

Filled hole with heavy mud from 3792 ft. to 250 ft.. Bridged hole at 250 ft. and ran 20 sacks cement on top of plug. Filled with heavy mud to 160 ft.; bridged hole at 160 ft. and ran 12 sacks cement on top of plug. Filled with heavy mud to bottom of cellar; cement plug to top of casing.

16 9 21W  
125 37

(If additional description is necessary, use BACK of this sheet)

Correspondence regarding this well should be addressed to Barnett Drilling Company  
Address First National Bank Building, Wichita 2, Kansas

STATE OF Kansas, COUNTY OF Sedgwick

W. R. Hunter (employee of owner) or (owner or operator) of the above-described well, being first duly sworn on oath, says: That I have knowledge of the facts, statements, and matters herein contained and the log of the above-described well as filed and that the same are true and correct. So help me God.

(Signature) W. R. Hunter

252 North Oliver

(Address)

SUBSCRIBED AND SWORN to before me this 2nd day of August

My commission expires July 17, 1948

Notary Public



BARNETT DRILLING COMPANY, ET AL

LOG OF BOLAND WELL #2

SE $\frac{1}{2}$  NE $\frac{1}{2}$  NW $\frac{1}{2}$  SECTION 16-9S-21W, GRAHAM COUNTY, KANSAS

<u>Formation</u>	<u>From</u>	<u>To</u>	<u>Remarks</u>
Surface Clay	0	30	
Shale and Sand	30	160	Set 10 3/4" Surface Pipe @ 157', cemented with 125 sacks
Shale and Shells	160	1175	
Shale	1175	1225	
Sand	1225	1425	
Shale and Shells	1425	1658	
Anhydrite	1658	1705	
Shale and Shells	1705	2246	
Lime	2246	2350	
Lime and Chert	2350	2385	
Shale and Shells	2385	2500	
Lime	2500	2585	
Broken Lime	2585	2700	
Lime	2700	2925	
Shale	2925	2963	
Topeka Lime	2963	3025	
Lime	3025	3110	
Lime-broken	3110	3210	
Lime and Shale	3210	3275	
Lime	3275	3361	
Cherty Lime	3361	3372	
Lime	3372	3380	
Shale and Lime	3380	3398	
K. C. Lime	3398	3440	
Lime	3440	3605	Circulated 1 hr. @ 3441
Lime and Shale	3605	3655	
Lime	3655	3792	Circulated 1 1/2 hrs. @ 3708; 1 1/2 hrs. @ 3711, 1 1/2 hrs. @ 3717; 1 1/2 hrs. @ 3735, 3/4 hr. @ 3779.
Total Depth		3792	Dry and Abandoned

CERTIFICATE

I hereby certify that the above is a true and correct log of the Boland Well #2, located in the SE $\frac{1}{2}$  NE $\frac{1}{2}$  NW $\frac{1}{2}$  of Section 16-9S-21W, Graham County, Kansas.

16 9 31W  
125 37 W. R. Hunter  
Office Manager - Barnett Drilling Company

Subscribed and sworn to before me, a Notary Public in and for the County of Sedgwick, State of Kansas, this third day of August, 1944.

R. P. [Signature]  
Notary Public

My commission expires Dec 11 - 1944  
~~July 17, 1948.~~