

STATE OF KANSAS  
CORPORATION COMMISSION

WELL PLUGGING RECORD

Graham County, Sec. 20 Twp. 9 Rge. 21 (X) (W)

Location as "NE/CNW/SW" or footage from lines 330' FNL & 1650' FWL

Lease Owner Cities Service Oil Company

Lease Name Davignon Well No. 2

Office Address Box 553, Russell, Kansas

Character of Well (completed as Oil, Gas or Dry Hole) Oil

Date well completed 5-18 19 50

Application for plugging filed 2-9 19 65

Application for plugging approved 2-10 19 65

Plugging commenced 2-19 19 65

Plugging completed 2-20 19 65


Reason for abandonment of well or producing formation Depleted

If a producing well is abandoned, date of last production 9-1 19 64

Was permission obtained from the Conservation Division or its agents before plugging was commenced? Yes

All Information Completely  
Required Affidavit  
Mail or Deliver Report to:  
Conservation Division  
State Corporation Commission  
211 No. Broadway  
Wichita, Kansas

NORTH

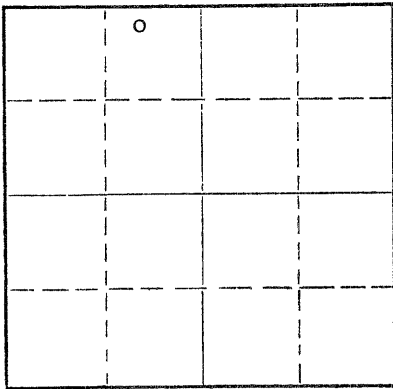

Locate well correctly on above  
Section Plat

Name of Conservation Agent who supervised plugging of this well W. L. Nichols

Producing formation Arbuckle Depth to top 3834' Bottom 3838' Total Depth of Well 3838' Feet

Show depth and thickness of all water, oil and gas formations.

OIL, GAS OR WATER RECORDS

CASING RECORD

FORMATION	CONTENT	FROM	TO	SIZE	PUT IN	PULLED OUT
				8 5/8"	279'	-0-
				5 1/2"	3836'	-0-

Describe in detail the manner in which the well was plugged, indicating where the mud fluid was placed and the method or methods used in introducing it into the hole. If cement or other plugs were used, state the character of same and depth placed, from \_\_\_\_\_ feet to \_\_\_\_\_ feet for each plug set.

P & A 10 A.M. 2-20-65 Filled with sand to 3498'

Filled up W/rock to 3492'

Dumped 2 sacks cement to 3472'

Filled W/mud and water 550

Pushed Howco Plug to 550

Filled with rock to 543

Filled W/2 sacks cement to 526

Loaded casing W/mud & Water to 40'

Pushed Howco plug to 40'

Filled with rock to 35'

Filled casing W/cement (5 sacks) to base of cellar

Job complete 10 A.M. Feb. 20, 1965

RECEIVED  
STATE CORPORATION COMMISSION  
2/24/65  
FEB 24 1965

CONSERVATION DIVISION  
Wichita, Kansas

(If additional description is necessary, use BACK of this sheet)

Name of Plugging Contractor Halliburton Company, Hays, Kansas

Address \_\_\_\_\_

STATE OF Kansas, COUNTY OF Russell, ss.  
M. M. Hardin

(employee of owner) or (owner or operator) of the above-described well, being first duly sworn on oath, says: That I have knowledge of the facts, statements, and matters herein contained and the log of the above-described well as filed and that the same are true and correct. So help me God.

(Signature) M. M. Hardin M. M. Hardin

Box 553, Russell, Kansas

(Address)

SUBSCRIBED AND SWORN TO before me this 22nd day of February, 19 65

My commission expires 10-5-68

James F. Kyger Notary Public.



15-065-19016-00-00

WELL RECORD

Company Cities Service Oil Co. Well No. 2 Farm Davignon

Location 330' S & 990' W. of N/4 Corner Sec. 20 T 9 R 21 W

Elev. 2316 (2314 Gr) Graham County State Kansas

T.D. 3838' Initial Prod. Draw-down potential: 3000 oil, no water 24 hrs (5-22-50)  
Indicated Capacity 5,395 bbls.

FORMATION RECORD:

shale & sand	0-279	Corr. Lansing	3518'
shale & shells	1180	Corr. Cherty Conglomerate	3796'
sand	1470	Corr. Simpson	3806'
Shale & shells	1630	Corr. Arbuckle	3834'
anhydrite	1655	Penetration	4'
shale	1840	Total depth	3838'
lime	2090		
shale & shells	2230		
shale	2360		
lime	2735		
lime & shale	2805		
shale & lime	2915		
lime	3105		
lime & shale	3430		
lime	3833		
3833 RTD = 3836 SIM			
lime	3838 TD		

RECEIVED  
STATE CORPORATION COMMISSION

FEB 24 1965

CONSERVATION DIVISION  
Wichita, Kansas