


Give All Information Completely
Make Required Affidavit
Mail or Deliver Report to:
Conservation Division
State Corporation Commission
800 Bittling Building
Wichita, Kansas

WELL PLUGGING RECORD

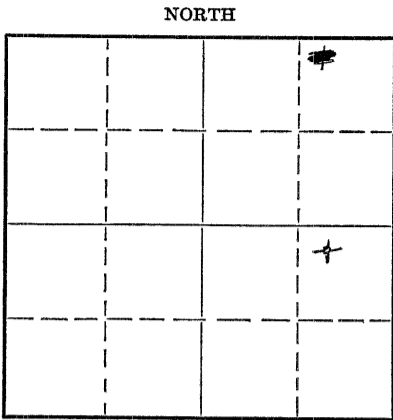

Locate well correctly on above Section Plat

Graham County, Sec. 20 Twp. 9S Rge. 21 (W)
Location as "NE/CNW $\frac{1}{4}$ SW $\frac{1}{4}$ " or footage from lines NW NE SE
Lease Owner Peel-Hardman
Lease Name Ford #1 Well No. 1
Office Address P. O. Box 359, Hoisington, Kansas
Character of Well (completed as Oil, Gas or Dry Hole) Dry Hole
Date well completed February 7, 1951
Application for plugging filed February 7, 1951
Application for plugging approved February 7, 1951
Plugging commenced February 7, 1951
Plugging completed February 7, 1951
Reason for abandonment of well or producing formation Dry Hole

If a producing well is abandoned, date of last production 19...
Was permission obtained from the Conservation Division or its agents before plugging was commenced? Yes

Name of Conservation Agent who supervised plugging of this well Mr. E. R. Petty
Producing formation Depth to top Bottom Total Depth of Well 3842 Feet
Show depth and thickness of all water, oil and gas formations.

OIL, GAS OR WATER RECORDS

CASING RECORD

Formation	Content	From	To	Size	Put In	Pulled Out
		0	158	8 5/8"	158	None

Describe in detail the manner in which the well was plugged, indicating where the mud fluid was placed and the method or methods used in introducing it into the hole. If cement or other plugs were used, state the character of same and depth placed, from feet to feet for each plug set.

3842' - 156 $\frac{1}{2}$ ' - Heavy Rotary Mud
156 $\frac{1}{2}$ ' - 155' - Wooden Plug
155' - 109' - 15 Sacks Cement
109' - 41 $\frac{1}{2}$ ' - Wooden Plug
40' - 6' - 10 Sacks Cement
6' - Surface - Cellar

RECEIVED
STATE CORPORATION COMMISSION
2/15/51
FEB 15 1951
CONSERVATION DIVISION
Wichita, Kansas

(If additional description is necessary, use BACK of this sheet)

Correspondence regarding this well should be addressed to Peel-Hardman
Address P. O. Box 359, Hoisington, Kansas

STATE OF KANSAS, COUNTY OF BARTON, ss.
Peel-Hardman (employee of owner) or (owner or operator) of the above-described well,

being first duly sworn on oath, says: That I have knowledge of the facts, statements, and matters herein contained and the log of the above-described well as filed and that the same are true and correct. So help me God.

(Signature) PEEL-HARDMAN
BY: *Marian M. Herbert*
P. O. Box 359, Hoisington, Kansas
(Address)

SUBSCRIBED AND SWORN TO before me this 14th day of February, 1951

Marian M. Herbert
Notary Public.

My commission expires June 4, 1951

28-5091-s 8-50-10M
PLUGGING
FILE SEC 20T 4 R2W
BOOK PAGE 61 LINE 13

DRILLER'S LOG

Company: Peel-Hardman

NW NE SE

Farm: Ford #1

Sec. 20 Twp. 9S Rge. 21W

Total Depth: 3842'

County: Graham

Com: 1-29-51 Comp: 2-7-51

Elevation:

Contractor: Peel-Hardman

Production: Dry

Casing :

8 5/8" 158' cem.

Figures below indicate bottom of formations:

Surface Soil and Shells	0 -	158
Sand and Shale		645
Shale		875
Sand		1005
Shale		1175
Sand		1350
Shale		1505
Shale and Shells		1760
Anhydrite		1800
Shale		1865
Shale and Shells		2575
Shale & Lime		2945
Shale		3125
Shale & Lime		3653
Lime		3785
Lime and Shale		3835
Lime and Conglomerate		3842
Total Depth		3842

This is to certify that the above information is, to the best of our knowledge, true and correct.

PEEL-HARDMAN

BY: *Wm Herbert*

SUBSCRIBED AND SWORN to before me this 14th day of February 1951.

My commission expires June 4, 1951

Marian M. Herbert
Notary Public

RECEIVED
STATE CORPORATION
FEB 15 1951

PLUGGING
FILE SEC 20T 9 R 21W
BOOK PAGE 61 LINE 13