

WELL PLUGGING RECORD


Give All Information Completely
Make Required Affidavit
Mail or Deliver Report to:
Conservation Division
State Corporation Commission
211 No. Broadway
Wichita, Kansas

Graham County, Sec. 20 Twp. 9S Rge. ~~20~~ 21 (W)

Location as "NE/CNW/SW" or footage from lines C W/2 SE NW
Lease Owner Rains & Williamson Oil Co.
Lease Name DAVIGNON "B" Well No. 1
Office Address 412 Union Center, Wichita 2, Kansas
Character of Well (completed as Oil, Gas or Dry Hole) Dry Hole
Date well completed January 22 19 63
Application for plugging filed January 22 19 63
Application for plugging approved January 22 19 63
Plugging commenced January 22 19 63
Plugging completed January 22 19 63

Reason for abandonment of well or producing formation No oil or gas found in commercial quantities.

If a producing well is abandoned, date of last production ----- 19
Was permission obtained from the Conservation Division or its agents before plugging was commenced? Yes

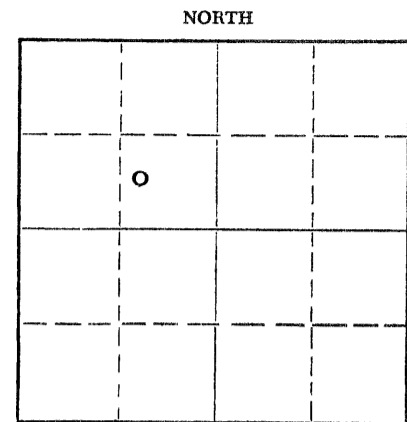

Locate well correctly on above Section Plat

Name of Conservation Agent who supervised plugging of this well Mr. Bill Nichols, Marland, Kansas
Producing formation None Depth to top --- Bottom --- Total Depth of Well 3900 Feet
Show depth and thickness of all water, oil and gas formations.

OIL, GAS OR WATER RECORDS

CASING RECORD

FORMATION	CONTENT	FROM	TO	SIZE	PUT IN	PULLED OUT
				8-5/8"	192'	None

Describe in detail the manner in which the well was plugged, indicating where the mud fluid was placed and the method or methods used in introducing it into the hole. If cement or other plugs were used, state the character of same and depth placed, from _____ feet to _____ feet for each plug set.

Set first plug at 540'. Cemented through drill pipe with 20 sacks cement. Filled hole with rotary mud to 180', set second plug. Cemented through drill pipe with 20 sacks cement. Filled hole with rotary mud to 40 feet of base of cellar. Set plug #3 with 1/2 sack hulls and capped with 10 sacks cement.

STATE CORPORATION COMMISSION
1/25/63
JAN 25 1963

CONSERVATION DIVISION
Wichita, Kansas

(If additional description is necessary, use BACK of this sheet)
Name of Plugging Contractor Rains & Williamson Oil Co.
Address 412 Union Center - Wichita 2, Kansas

STATE OF KANSAS COUNTY OF SEDGWICK
Wilson Rains - Partner, ss.

well, being first duly sworn on oath, says: That I have knowledge of the facts, statements, and matters herein contained and the log of the above-described well as filed and that the same are true and correct. So help me God.

(Signature) Wilson Rains Wilson Rains
412 Union Center - Wichita 2, Kansas
(Address)

SUBSCRIBED AND SWORN TO before me this 24th day of January, 19 63

My commission expires November 8, 1966

Sherry Gish
Sherry Gish Notary Public.

ROTARY DRILLING LOG

Operator: Rains & Williamson Oil Co.
 NO. 1 DAVIGNON "B"
 E 1/2 SE NW Sec. 20-9S-21W
 Graham County, Kansas

Contractor: Rains & Williamson
 Commenced: 1-14-63
 Completed: 1-22-63

Remarks: Set 8-5/8" surface casing at 192' with 135 sacks cement.

Formations:

Surface Clay and Sand	42'
Clay and Shale	203'
Shale and Shells	920'
Shale	1130'
Shale and Shells	1623'
Shale and Red Beds	1810'
Crystalite	1850'
Shale and Shells	2250'
Shale and Lime	2495'
Shale and Shale	2860'
Shale	3035'
Shale and Shale	3175'
Crystally Lime and Shale	3265'
Shale and Shale	3525'
Shale	3900'
Drilling Total Depth (D&A)	3900'

RECEIVED
 STATE CORPORATION COMMISSION

JAN 25 1963

CONSERVATION DIVISION
 Wichita, Kansas

We certify the above log is true and correct to the best of our knowledge and belief.

RAINS & WILLIAMSON OIL CO.

Wilson Rains
 Wilson Rains
 Partner

As described and sworn to before me, a Notary Public in and for the State of Kansas, County of Sedgwick, this 24th day of January, 1963.

Sherry Gish
 Sherry Gish Notary Public

Commission Expires: Nov. 8, 1966