


STATE OF KANSAS  
STATE CORPORATION COMMISSION

Give All Information Completely  
Make Required Affidavit  
Mail or Deliver Report to:  
Conservation Division  
State Corporation Commission  
211 No. Broadway  
Wichita, Kansas

WELL PLUGGING RECORD

NORTH

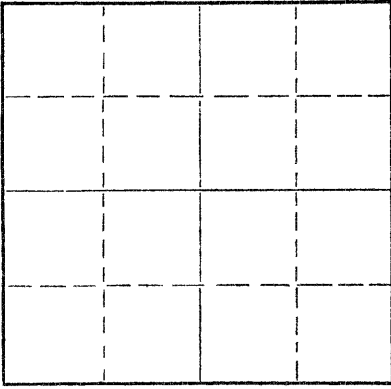

Locate well correctly on above  
Section Plat

Graham County. Sec. 19 Twp. 9S Rge. 21W (E) (W)  
Location as "NE/CNW/SW" or footage from lines NE-SW-NW  
Lease Owner Cities Service Oil Company, Bartlesville, Oklahoma  
Lease Name Pricer Well No. 4  
Office Address Box 553, Russell, Kansas  
Character of Well (completed as Oil, Gas or Dry Hole) Dry Hole  
Date well completed 9-12-19 59  
Application for plugging filed 9-12-19 59  
Application for plugging approved 9-13-19 59  
Plugging commenced 9-13-19 59  
Plugging completed 9-13-19 59  
Reason for abandonment of well or producing formation Non Commercial

If a producing well is abandoned, date of last production 19  
Was permission obtained from the Conservation Division or its agents before plugging was commenced? Yes

Name of Conservation Agent who supervised plugging of this well Eldon Petty  
Producing formation Depth to top Bottom Total Depth of Well 3965' Feet  
Show depth and thickness of all water, oil and gas formations.

OIL, GAS OR WATER RECORDS

CASING RECORD

FORMATION	CONTENT	FROM	TO	SIZE	PUT IN	PULLED OUT
				8-5/8"	240'	-0-

Describe in detail the manner in which the well was plugged, indicating where the mud fluid was placed and the method or methods used in introducing it into the hole. If cement or other plugs were used, state the character of same and depth placed, from feet to feet for each plug set.

Filled hole w/heavy Rotary mud 3965' to 600';  
Pushed Howco wooden plug and 1/2 sack hulls to 600';  
Put in 20 sx. cement thru drill pipe to 600-533';  
Filled hole w/heavy mud thru drill pipe 553-180';  
20 sx. cement thru drill pipe 180-115';  
Heavy mud thru drill pipe 115-35';  
Pushed Howco wooden plug and 1/2 sack hulls to 35';  
Filled hole w/10 sx. cement 35' to surface;  
Job complete @ 2:30 PM 9/13/59 -(Final RTD 3965' Lime)

RECEIVED  
STATE CORPORATION COMMISSION  
5/9/63  
MAY 9 1963

CONSERVATION DIVISION  
Wichita, Kansas

(If additional description is necessary, use BACK of this sheet)

Name of Plugging Contractor Peel Bros., Inc.  
Address Hoisington, Kansas

STATE OF KANSAS, COUNTY OF BARTON, ss.  
M. M. Hardin (employee of owner) of the above-described well, being first duly sworn on oath, says: That I have knowledge of the facts, statements, and matters herein contained and the log of the above-described well as filed and that the same are true and correct. So help me God.

(Signature) /s/ M. M. Hardin  
Box 553, Russell, Kansas  
(Address)

(SEAL)

SUBSCRIBED AND SWORN TO before me this 25th day of September, 19 59

/s/W. G. Smith

My commission expires March 12, 1963

Notary Public.



DRILLERS' LOG

Well Owner: Cities Service Oil Company  
 Farm Name: Pricer Well No. 4  
 Commenced: 8/30/59  
 Completed: 9/13/59  
 Total Depth: 3965'  
 Casing: 8 5/8" @ 239' cemented  
 Contractor: Peel Brothers, Inc.

C NE SW NW  
 Sec. 19-9S-21W  
 Graham County, Kansas  
 Elevation:  
 Production: Dry

FIGURES BELOW INDICATE BOTTOMS OF FORMATIONS:

Shale	-0-	100
Sand		180
Shale		615
Shale, sand & shells		1415
Sand		1520
Shale		1820
Anhydrite		1860
Shale & lime		2860
Lime		2920
Lime & shale		3280
Lime		3470
Lime & shale		3520
Lime		3775
Lime & shale		3825
Lime		3865
Lime & shale		3891
Lime		3901
Lime, chert & shale		3917
Shale & lime		3937
Lime, shale & chert		3960
Lime		3965
Total Depth		3965

RECEIVED  
 STATE CORPORATION COMMISSION

SEP 24 1959

CONSERVATION DIVISION  
 Wichita, Kansas

**PLUGGING**

File Sec. 19 T. 9 R. 21W  
 Book Page 4 Line 19