


15-065-00148-00-00

STATE OF KANSAS
STATE CORPORATION COMMISSION

WELL PLUGGING RECORD

Give All Information Completely
Make Required Affidavit
Mail or Deliver Report to:
Conservation Division
State Corporation Commission
800 Bitting Building
Wichita, Kansas

NORTH

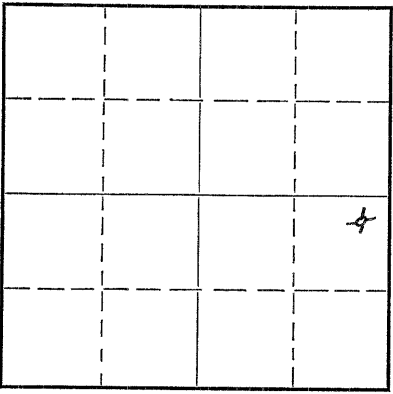

Locate well correctly on above
Section Plat

Graham County. Sec. 19 Twp. 9S Rge. 21W (E) (W)
Location as "NE/CNW $\frac{1}{4}$ SW $\frac{1}{4}$ " or footage from lines NE $\frac{1}{4}$ NE $\frac{1}{4}$ SE $\frac{1}{4}$
Lease Owner Peel-Hardman Producers
Lease Name Pricer Well No. 1
Office Address P.O. Box 359 Hoisington, Kansas
Character of Well (completed as Oil, Gas or Dry Hole) Dry Hole Kansas
Date well completed April 11, 1950
Application for plugging filed April 11, 1950
Application for plugging approved April 11, 1950
Plugging commenced April 11, 1950
Plugging completed April 11, 1950
Reason for abandonment of well or producing formation Dry Hole

If a producing well is abandoned, date of last production _____ 19____
Was permission obtained from the Conservation Division or its agents before plugging was commenced? Yes

Name of Conservation Agent who supervised plugging of this well E.R. Petty
Producing formation _____ Depth to top _____ Bottom _____ Total Depth of Well 3930' Feet
Show depth and thickness of all water, oil and gas formations.

OIL, GAS OR WATER RECORDS

CASING RECORD

Formation	Content	From	To	Size	Put In	Pulled Out
		0	160'	8 5/8"	160'	None

Describe in detail the manner in which the well was plugged, indicating where the mud fluid was placed and the method or methods used in introducing it into the hole. If cement or other plugs were used, state the character of same and depth placed, from _____ feet to _____ feet for each plug set.

- 3930' - 156 $\frac{1}{2}$ ' - Heavy Rotary Mud
- 156 $\frac{1}{2}$ ' - 155' - Wooden Plug
- 155' - 108' - 15 sacks cement
- 108' - 41 $\frac{1}{2}$ ' - Heavy Rotary Mud
- 41 $\frac{1}{2}$ ' - 40' - Wooden Plug
- 40' - 6' - 10 sacks cement
- 6' - Surface - Cellar

4/18/50

(If additional description is necessary, use BACK of this sheet)

Correspondence regarding this well should be addressed to Peel-Hardman Producers
Address P.O. Box 359 Hoisington, Kansas

STATE OF Kansas, COUNTY OF Barton, ss.

Glenn Peel Drilling Co., Inc. (employee of owner) or (owner or operator) of the above-described well, being first duly sworn on oath, says: That I have knowledge of the facts, statements, and matters herein contained and the log of the above-described well as filed and that the same are true and correct. So help me God. GLENN PEEL DRILLING CO., INC.
BY: [Signature]
(Signature) P.O. Box 359 Hoisington, Kansas
(Address)

SUBSCRIBED AND SWORN TO before me this 14th day of April, 1950

Marion M. Herbert
Notary Public.

My commission expires June 4, 1951

PLUGGING
REC-191-9-21W
LINE 11

DRILLER'S LOG

Company: Peel-Hardman Producers
 Derby Oil Co. & R. W. Shields

Sec. 19 Twp. 9S Rge. 21W
 NE $\frac{1}{4}$ NE $\frac{1}{4}$ SE $\frac{1}{4}$

Farm: Pricer Well No. 1

Total Depth: 3930'

County: Graham County,
 Kansas

Comm: 4-1-50 Comp: 4-11-50

Contractor: Glenn Peel Drilling Co., Inc.

Elevation:

Casing:
 8 5/8" 160'

Production: *Dry*

Figures below indicate bottom of formation

Surface Clay	0 -	45
Sand Streaks		105
Shale & Shells		161
Shale		720
Sand		850
Sand & Shale		1200
Sand		1330
Shale & Sand		1500
Shale & Shells		1840
Anhydrite		1875
Shale & Shells		2295
Shale & Lime		2460
Lime & Shale		2585
Lime		2695
Lime & Shale		2840
Shale & Lime		3005
Shale & Lime Streaks		3190
Lime & Shale		3500
Lime		3906
Conglomerate		3930
Total Depth		3930

This is to certify that the above information is, to the best of our knowledge, true and correct.

GLENN PEEL DRILLING COMPANY, INC.

BY: *J. B. [Signature]*

SUBSCRIBED AND SWORN TO before me this 14th day of April, 1950

My commission expires June 4, 1951 *Marion M. Herfest*
 Notary Public

19, 9, 21W
 PAGE 1 LINE 11