


STATE OF KANSAS
STATE CORPORATION COMMISSION

WELL PLUGGING RECORD

Give All Information Completely
Make Required Affidavit
Mail or Deliver Report to:
Conservation Division
State Corporation Commission
800 Bitting Building
Wichita, Kansas

Graham County, Sec. 19 Twp. 9S Rge. 21W ~~(18)~~ (17)
Location as "NE/CNW $\frac{1}{4}$ SW $\frac{1}{4}$ " or footage from lines NE NE SW
Lease Owner Peel-Hardman
Lease Name Van Loenan Well No. 1
Office Address P. O. Box 359, Hoisington, Kansas
Character of Well (completed as Oil, Gas or Dry Hole) Dry hole
Date well completed May 3 19 50
Application for plugging filed May 3 19 50
Application for plugging approved May 3 19 50
Plugging commenced May 3 19 50
Plugging completed May 3 19 50
Reason for abandonment of well or producing formation Dry hole

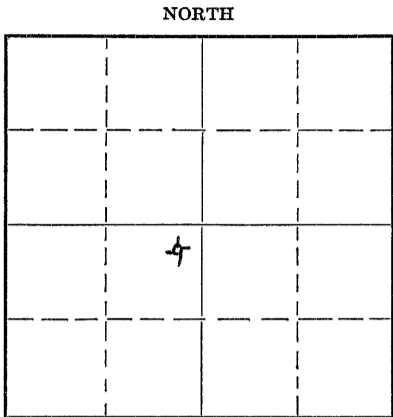

Locate well correctly on above Section Plat

If a producing well is abandoned, date of last production 19
Was permission obtained from the Conservation Division or its agents before plugging was commenced? Yes

Name of Conservation Agent who supervised plugging of this well E. R. Petty
Producing formation _____ Depth to top _____ Bottom _____ Total Depth of Well 3980 Feet
Show depth and thickness of all water, oil and gas formations.

OIL, GAS OR WATER RECORDS

CASING RECORD

Formation	Content	From	To	Size	Put In	Pulled Out
		0	160	8 5/8	160	None

Describe in detail the manner in which the well was plugged, indicating where the mud fluid was placed and the method or methods used in introducing it into the hole. If cement or other plugs were used, state the character of same and depth placed, from _____ feet to _____ feet for each plug set.

3980'	-	156 $\frac{1}{2}$ '	-	Heavy Rotary Mud
156 $\frac{1}{2}$ '	-	155'	-	Wooden Plug
155'	-	109'	-	15 sacks cement
109'	-	36 $\frac{1}{2}$ '	-	Heavy Rotary Mud
36 $\frac{1}{2}$ '	-	35'	-	Wooden Plug
35'	-	6'	-	10 sacks cement
6'	-	Surface	-	Cellar

RECEIVED
5/9/50
MAY 9 - 1950
STATE CORPORATION
COMMISSION
DIVISION

(If additional description is necessary, use BACK of this sheet)
Correspondence regarding this well should be addressed to Peel-Hardman
Address P. O. Box 359, Hoisington, Kansas

STATE OF Kansas, COUNTY OF Barton, ss.
Glenn Peel Drilling Co., Inc. (employee of owner) or ~~(owner or operator)~~ of the above-described well, being first duly sworn on oath, says: That I have knowledge of the facts, statements, and matters herein contained and the log of the above-described well as filed and that the same are true and correct. So help me God. GLENN PEEL DRILLING COMPANY, INC.
(Signature) BY: Murdell L. Tech
P. O. BOX 359, Hoisington, Kansas
(Address)

SUBSCRIBED AND SWORN to before me this 8th day of May, 1950
Marian M. Herber
Notary Public.

My commission expires June 4, 1951

FILED
FILE SEC. 19-19-216
BOOK PAGE 4 LINE 25

15-065-20170-00-00

DRILLERS' LOG

Company: Peel-Hardman, N. Appleman Co.
and R. W. Shields

Sec. 19 Twp. 9S Rge. 21W
NE NE SW

Farm Name: Van Loenen Well No. 1
Total Depth: 3980'

County: Graham,
Kansas

Comm.: 4-23-50 Comp.: 5-3-50
Contractor: Glenn Peel Drilling Co., Inc.
Casing:
8 5/8" 160' cem.

Elevation:
Production: Dry

Figures below indicate bottom of formations.

Surface Clay	0 -	20
Sand and Shells		135
Shale		800
Shale and Shells		925
Sand		1060
Shale and Sand		1200
Shale and Shells w/sand streaks		1760
Shale and Shells		1868
Anhydrite		1904
Shale and Shells		2095
Lime and Shale		2280
Broken Lime w/Shale Streaks		2460
Lime and Shale		3460
Lime		3920
Conglomerate		3940
Lime		3980
Total Depth		3980

This is to certify that the above information is, to the best of our knowledge, true and correct.

GLENN PEEL DRILLING COMPANY, INC.

BY: Mendell E. Peel

SUBSCRIBED AND SWORN to before me this 8th day of May, 1950

My commission expires June 4, 1951 Marion M. Herbst

RECEIVED
MAY 9 - 1950
STATE CORPORATION
COMMISSION
KANSAS

LOGGING
19 9-21W
PAGE 4 LINE 25