


STATE OF KANSAS
STATE CORPORATION COMMISSION

WELL PLUGGING RECORD

Give All Information Completely
Make Required Affidavit
Mail & Deliver Report to:
Conservation Division
State Corporation Commission
800 Bitting Building
Wichita, Kansas

Graham County, Sec. 19 Twp. 9S Rge. 21 (E) W (W)

Location as "NE/CNW $\frac{1}{4}$ SW $\frac{1}{4}$ " or footage from lines NE NW NE
Lease Owner R. W. SHIELDS, ET AL
Lease Name FURY Well No. 1
Office Address 1307 SHARP BLDG., LINCOLN, NEBRASKA
Character of Well (completed as Oil, Gas or Dry Hole) OIL
Date well completed June 19 19 51
Application for plugging filed February 2 19 52
Application for plugging approved February 2 19 52
Plugging commenced February 17 19 52
Plugging completed February 20 19 52
Reason for abandonment of well or producing formation INSUFFICIENT
PRODUCTION FOR COMMERCIAL OPERATION
If a producing well is abandoned, date of last production January 26 19 52
Was permission obtained from the Conservation Division or its agents before plugging was commenced? Yes

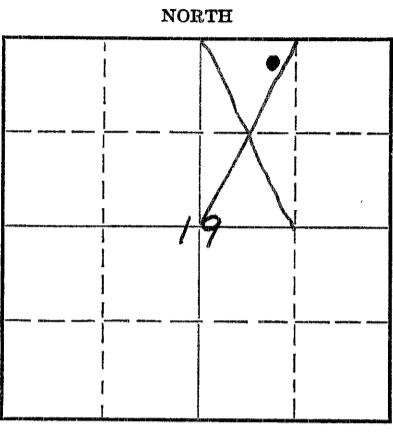

Locate well correctly on above Section Plat

Name of Conservation Agent who supervised plugging of this well Eldon Petty
Producing formation Arbuckle Depth to top 3866 Bottom - Total Depth of Well 3897 Feet
Show depth and thickness of all water, oil and gas formations.

OIL, GAS OR WATER RECORDS

CASING RECORD

Formation	Content	From	To	Size	Put In	Pulled Out
SURFACE SOIL		0	157'	8 5/8"	157'	None
LANGING-KANSAS CITY	DRY	3560'	3777'	5 1/2"	3868'	3208'
ARBUCKLE	OIL	3866'	-			

Describe in detail the manner in which the well was plugged, indicating where the mud fluid was placed and the method or methods used in introducing it into the hole. If cement or other plugs were used, state the character of same and depth placed, from _____ feet to _____ feet for each plug set.

DUMPED 4 SACKS OF CEMENT AT 3860'. SHOT PIPE OFF AT 3208'. PULLED PIPE AND MUDDING HOLE TO 200'. SET ROCK BRIDGE AND DUMPED 15 SACKS OF CEMENT AT 200'. FINISHED MUDDING HOLE AND DUMPED 10 SACKS OF CEMENT AT TOP OF SURFACE.

3/10/52

Name of Plugging Contractor BERT SELF
Address 419 EAST SIXTH STREET HUTCHINSON, KANSAS

STATE OF NEBRASKA, COUNTY OF LANCASTER, ss.
N. J. SHIELDS (employee of owner) or (owner or operator) of the above-described well, being first duly sworn on oath, says: That I have knowledge of the facts, statements, and matters herein contained and the log of the above-described well as filed and that the same are true and correct. So help me God.

(Signature) N. J. Shields
1307 SHARP BLDG., LINCOLN, NEBRASKA (Address)

SUBSCRIBED AND SWORN to before me this 3rd day of March, 1952
Notary Public

My commission expires 9-13-1953 23-8390-6-51-20M

PLUGGING
FILE SEC 19 T 9 R 2 (W)
BOOK PAGE 14 LINE 15

DRILLER'S LOG

Company: Peel-Hardman

Farm: Fury Well No. 1
Total Depth: 3870'

Comm: 5-26-51 Comp: 6-3-51

Contractor: Peel-Hardman

Casing:

8 5/8" 157' cem
5 1/2" 3868' cem

NE NW NE
Sec. 19, Twp. 9S, Rgs. 21W

County: Graham,
Kansas

Elevation: 2341 D. F.

Production:

Figures below indicate bottom of formations

Surface Soil	0 -	165
Shale		975
Sand		1100
Sand & Shale		1250
Shale & Shells		1350
Sand		1450
Shale & Shells		1625
Anhydrite		1870
Shale & Shells		2600
Lime & Shale		2990
Shale		3105
Shale & Shells		3240
Shale, Shells & Lime		3330
Shale & Shells		3440
Lime & Shale		3525
Lime		3870
Total Depth		3870

This is to certify that the above information is, to the best of our knowledge true and correct.

PEEL-HARDMAN

BY: Mary Herbert

SUBSCRIBED AND SWORN to before me this 13th day of June, 1951.

My commission expires June 4, 1955

Marian M. Herbert
Notary Public

Geologic Tops:
Heebner 3519 D.F.
Lansing 3558 D.F.
Arbuckle 3864 D.F.

PLUGGING
FILE SEC 19 T 9 R 21W
BOOK PAGE 142 LINE 5