

STATE OF KANSAS
STATE CORPORATION COMMISSION


WELL PLUGGING RECORD

Give All Information Completely
Make Required Affidavit
Mail or Deliver Report to:
Conservation Division
State Corporation Commission
211 No. Broadway
Wichita, Kansas

Graham County, Sec. 17 Twp. 9S Rge. 21 (XX) (W)

Location as "NE/CNW/SW" or footage from lines NW NW SW
Lease Owner American Petrofina Co. of Texas
Lease Name Cooley 'A'
Office Address 4613 Jacksboro Hwy., Wichita Falls, Tex. 76302
Character of Well (completed as Oil, Gas or Dry Hole) Oil
Date well completed 12-21 19 55
Application for plugging filed 4-11 19 83
Application for plugging approved 6-10 19 83
Plugging commenced 6-24 19 83
Plugging completed 6-24 19 83
Reason for abandonment of well or producing formation Uneconomical to operate

NORTH

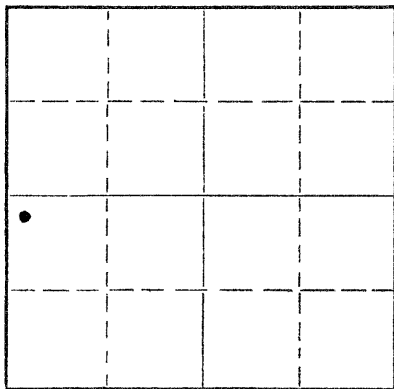

Locate well correctly on above
Section Plat

If a producing well is abandoned, date of last production 5-12 19 80
Was permission obtained from the Conservation Division or its agents before plugging was commenced? yes

Name of Conservation Agent who supervised plugging of this well Carl Goodrow
Producing formation Arbuckle Depth to top 3820 Bottom 3825 Total Depth of Well 3825 Feet
Show depth and thickness of all water, oil and gas formations.

OIL, GAS OR WATER RECORDS

CASING RECORD

FORMATION	CONTENT	FROM	TO	SIZE	PUT IN	PULLED OUT
		Surface	200	8-5/8	200	0
		Surface	3818	5-1/2	3818	0
		Surface	3818	2-7/8	3818	0
		(tubing sanded in well)				

Describe in detail the manner in which the well was plugged, indicating where the mud fluid was placed and the method or methods used in introducing it into the hole. If cement or other plugs were used, state the character of same and depth placed, from _____ feet to _____ feet for each plug set.

Pumped 210 sx 50/50 Poz with 6% gel, 3% cacl down
5 -1/2" Casing. Pressured to 500#.

RECEIVED
STATE CORPORATION COMMISSION
7/6/83
JUL 06 1983
CONSERVATION DIVISION
Wichita, Kansas

(If additional description is necessary, use BACK of this sheet)

Name of Plugging Contractor Allied Cementers
Address Russell, Kansas

STATE OF Texas, COUNTY OF Wichita, ss.
R. M. Albers (employee of owner) or (owner or operator) of the above-described

well, being first duly sworn on oath, says: That I have knowledge of the facts, statements, and matters herein contained and the log of the above-described well as filed and that the same are true and correct. So help me God.

(Signature) R M Albers
4613 Jacksboro Hwy., Wichita Falls, Tx. 76302
(Address)

SUBSCRIBED AND SWORN TO before me this 30th day of June, 19 83

My commission expires 6-30- 83

Sybil Buntyn
Notary Public.

WELL LOG BUREAU - KANSAS GEOLOGICAL SOCIETY
508 East Murdock, Wichita, Kansas


COPY

Company- BARNETT DRILLING, INC.
Farm- Cooley "A" No. 11

SEC. 17 T. 9 R. 21W
NW NW SW

Total Depth. 3825'
Comm. 12-5-55 Comp. 12-16-55
Shot or Treated.
Contract No.
Issued. 3-10-56

County Graham
KANSAS

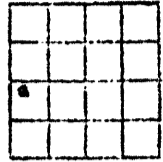

Elevation. 2322' RB

Production. 100 BOPD

CASING:

8 5/8" 200' com w/150 sx
5 1/2" 3822' com w/125 sx

Figures Indicate Bottom of Formations

shale	40	
sand	120	
shale	200	
shale	640	
sand and shale	1500	
shale	1818	
anhydrite	1852	
shale	2430	-108
shale and lime	3345	-1023
lime	3825	-1503
Total Depth		

Tops: Scout		
Heebner	3479	-1157
Lansing	3516	-1194
Arbuckle	3820	-1498

B/KC = 3732
2322
1410

G TOP -> 3586
2322
1264 ✓

G1 TOP 3610
2322
1288

D5T TOP 1264
1288

J TOP - 3702

G1 BOTTOM 3636 -1314

RECEIVED
STATE CORPORATION COMMISSION

APR 14 1983

CONSERVATION DIVISION
Wichita, Kansas