

STATE OF KANSAS
STATE CORPORATION COMMISSION


WELL PLUGGING RECORD

Give All Information Completely
Make Required Affidavit
Mail or Deliver Report to:
Conservation Division
State Corporation Commission
211 No. Broadway
Wichita, Kansas

Graham County, Sec. 17 Twp. 9S Rge. 21 (XX) (W)

Location as "NE/CNW/SW" or footage from lines SW:SW NW
Lease Owner American Petrofina Co. of Texas
Lease Name Cooley 'B' Well No. 2
Office Address 4613 Jacksboro Hwy., Wichita Falls, Texas 76302
Character of Well (completed as Oil, Gas or Dry Hole) Oil
Date well completed 3-31 1950
Application for plugging filed 4-11 1983
Application for plugging approved 6-10 1983
Plugging commenced 6-24 1983
Plugging completed 6-24 1983
Reason for abandonment of well or producing formation Uneconomical to operate

NORTH

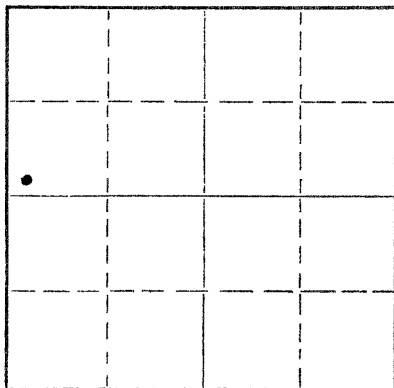

Locate well correctly on above
Section Plat

If a producing well is abandoned, date of last production 10-18 19 83
Was permission obtained from the Conservation Division or its agents before plugging was commenced? yes

Name of Conservation Agent who supervised plugging of this well Carl Goodrow
Producing formation Arbuckle Depth to top 3804 Bottom - Total Depth of Well 3815 Feet
Show depth and thickness of all water, oil and gas formations.

OIL, GAS OR WATER RECORDS

CASING RECORD

FORMATION	CONTENT	FROM	TO	SIZE	PUT IN	PULLED OUT
		Surface	195	8-5/8	195	0
		Surface	3804	5-1/2	3804	0
		17	3804	2-7/8	3804	17
		(sanded in well)				

Describe in detail the manner in which the well was plugged, indicating where the mud fluid was placed and the method or methods used in introducing it into the hole. If cement or other plugs were used, state the character of same and depth placed, from feet to feet for each plug set.

Pumped 245 sx 50/50 Poz w/6% gel, 3% CaCl.

Cemented down 5 1/2" casing & 150 sx down

8-5/8" casing. Pressured to 500#.

(If additional description is necessary, use BACK of this sheet)

Name of Plugging Contractor Allied Cementers
Address Russell, Kansas

STATE OF Texas, COUNTY OF Wichita, ss.
R. M. Albers (employee of owner) or (XXXXXX) of the above-described

well, being first duly sworn on oath, says: That I have knowledge of the facts, statements, and matters herein contained and the log of the above-described well as filed and that the same are true and correct. So help me God.

(Signature) Rm Albers

4613 Jacksboro Hwy., Wichita Falls, Texas 76302
(Address)

SUBSCRIBED AND SWORN TO before me this 30th day of June, 19 83

My commission expires 6-30-84

Sybil Dunton
Notary Public.

RECEIVED
STATE CORPORATION COMMISSION
7/6/83
JUL 06 1983

CONSERVATION DIVISION
Wichita, Kansas

WELL LOG BUREAU - KANSAS GEOLOGICAL SOCIETY
508 E. Murdock, Wichita, Kansas

COPY


15-065-02909-00-00

Company - PALMER OIL CORP & NATL. COOP. REFG. ASS'N. SEC.
Farm - Cooley "B" No. 2

17 T. 9 S. 21W
SW SW NW

Total Depth. 3815
Comm. 3-12-50 Comp. 3-28-50
Shot or Treated.
Contractor. Palmer Oil Corp.
Issued. 4-29-50

County. Graham
KANSAS

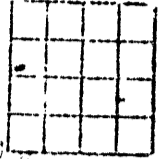

CASING:

8 5/8" 195' cem w/125 sx.
5 1/2" 3804' cem w/75 sx.

Elevation. 2204 ft

Production. 3000 bbls.

Figures Indicate Bottom of Formations.

cellar	10	
sand	60	
shale, sand	195	
shale, shells	758	
sand, shale, shells	1785	
anhyd.	1820	
shale, shells	2174	
lime brkn	2460	
lime, shale	2735	
lime brkn	3020	
shale, lime shells	3130	
lime, shale	3246	- 542
lime, brkn	3399	- 1095
lime	3458	- 1154
shale	3461	- 1157
lime, shale	3507	- 1203
lime	3768	- 1464
congl.	3790	- 1486
lime	3804	- 1500
lime Arb. RTD	3805	- 1501
arb. lime	3815	- 1511
Total depth		

Tops: R. B.
Heebner 3458 - 1154
Lansing 3496 - 1152
Arbuckle 3804 - 1500

DST 3499-3501, open 1/2 hr, rec. 90'
fluid, 2' free oil.

RECEIVED
STATE CORPORATION COMMISSION

APR 14 1983

CONSERVATION DIVISION
Wichita, Kansas