


15-163-00671-00-00

WELL PLUGGING RECORD

Give All Information Completely  
Make Required Affidavit  
Mail or Deliver Report to:  
Conservation Division  
State Corporation Commission  
800 Bitting Building  
Wichita, Kansas

Rooks County. Sec. 11 Twp. 10S Rge. 19 (E) W(W)  
Location as "NE/CNW%SW%" or footage from lines NE/4 NE/4 NW/4  
Lease Owner Clyde King, Jr., and J. E. Sawtelle  
Lease Name Husted Well No. 1  
Office Address Suite 305, 611 South Boston, Tulsa, Oklahoma  
Character of Well (completed as Oil, Gas or Dry Hole) Dry Hole  
Date well completed March 29, 19 54  
Application for plugging filed (Verbal) March 29, 19 54  
Application for plugging approved (Verbal) March 29, 19 54  
Plugging commenced March 29, 19 54  
Plugging completed March 29, 19 54  
Reason for abandonment of well or producing formation Dry Hole

NORTH

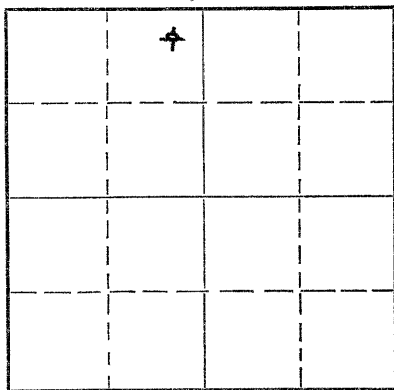

Locate well correctly on above  
Section Plat

If a producing well is abandoned, date of last production 19  
Was permission obtained from the Conservation Division or its agents before plugging was commenced? Yes

Name of Conservation Agent who supervised plugging of this well Eldon Petty  
Producing formation \_\_\_\_\_ Depth to top \_\_\_\_\_ Bottom \_\_\_\_\_ Total Depth of Well 3684 Feet  
Show depth and thickness of all water, oil and gas formations.

OIL, GAS OR WATER RECORDS

CASING RECORD

FORMATION	CONTENT	FROM	TO	SIZE	PUT IN	PULLED OUT
		0	164'	8-5/8"	164'	none

Describe in detail the manner in which the well was plugged, indicating where the mud fluid was placed and the method or methods used in introducing it into the hole. If cement or other plugs were used, state the character of same and depth placed, from \_\_\_\_\_ feet to \_\_\_\_\_ feet for each plug set.

15 sacks cement, 1/2 sack hulls on bottom.  
Plug set at 160'. 10 sacks cement on top.  
Plug set at 40'. Filled with mud to surface.


07-02-1954

Name of Plugging Contractor Birmingham-Bartlett Drilling Co.  
Address 300 Kaufman Building, Wichita 2, Kansas

STATE OF Kansas, COUNTY OF Sedgwick  
Richard Hindery, Partner of Birmingham-Bartlett Drilling Co., ss. contractor for  
well, being first duly sworn on oath, says: That I have knowledge of the facts, statements, and matters herein contained and the log of the above-described well as filed and that the same are true and correct. So help me God. BIRMINGHAM-BARTLETT DRILLING CO.  
(Signature) By Richard Hindery Partner  
300 Kaufman Building, Wichita 2, Kansas  
(Address)

SUBSCRIBED AND SWORN TO before me this 30th day of March, 19 54

My commission expires October 2, 1954  
Beverly Larson  
Notary Public.

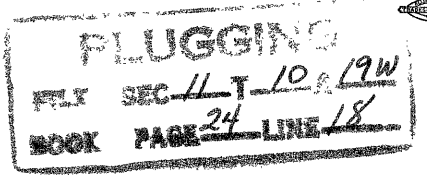

15-163-00671-00-00

HUSTED NO. 1 WELL

LOCATION: NE/4 NE/4 NW/4  
 Sec. 11-10S-19W  
 Rooks County, Kansas

SPUDDED: 3-16-54  
 COMPLETED: 3-29-54

OPERATOR: Clyde King, Jr., and J. E. Sawtelle  
 Suite 305, 611 South Boston  
 Tulsa, Oklahoma

CONTRACTOR: Birmingham-Bartlett Drilling Co.  
 300 Kaufman Building  
 Wichita 2, Kansas

SURFACE CASING: 8-5/8" casing set at 164' with  
 125 sacks cement and 1 cc.

OIL STRING: None set. D & A.

L O G

(Figures indicate bottom of formation)

0 -	3	Surface
	20	Clay
	34	Sand
	45	Chalk rock
	95	Gray shale
	164	Blue shale
	525	Shale
	1015	Shale and shells
	1230	Sand
	1375	Shale and shells
	1507	Shale
	1545	Anhydrite
	1985	Shale and shells
	3120	Shale and lime
	3580	Lime
	3623	Chert and Lime
	3645	Cherty conglomerate
	3664	Conglomerate
	3684	Lime
	3684	RTD - D & A

04-02-1954

The undersigned, Richard Hindery, one of the partners of Birmingham-Bartlett Drilling Co., hereby certifies that the above is a true and correct log of the formations encountered in drilling the Husted No. 1 Well as shown in the daily drilling reports.

BIRMINGHAM-BARTLETT DRILLING CO.

By Richard Hindery

Subscribed and sworn to before me  
this 30th day of March, 1954

Beverly Larson  
Notary Public

My commission expires October 2, 1954

