


15-163-00760-00-00

WELL PLUGGING RECORD

Give All Information Completely
Make Required Affidavit
Mail or Deliver Report to:
Conservation Division
State Corporation Commission
211 No. Broadway
Wichita, Kansas

NORTH

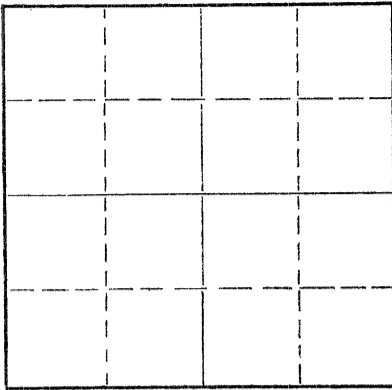

Locate well correctly on above
Section Plat

Rooks _____ County. Sec. 23 Twp. 10S Rge. 19 (E) W (W)
Location as "NE/CNW/SW" or footage from lines NW SW NE
Lease Owner Davis Bros. - Transit Corporation
Lease Name Catudal "B" Well No. 1
Office Address 1516 Liberty Bank Bldg., Oklahoma City, Oklahoma
Character of Well (completed as Oil, Gas or Dry Hole) D. & A.
Date well completed July 3, 1958
Application for plugging filed July 3, 1958
Application for plugging approved July 3, 1958
Plugging commenced July 3, 1958
Plugging completed July 3, 1958
Reason for abandonment of well or producing formation No Production

If a producing well is abandoned, date of last production 19
Was permission obtained from the Conservation Division or its agents before plugging was commenced? Yes

Name of Conservation Agent who supervised plugging of this well Eldon Petty, Box 326, Hays, Kansas
Producing formation _____ Depth to top _____ Bottom _____ Total Depth of Well _____ Feet
Show depth and thickness of all water, oil and gas formations.

OIL, GAS OR WATER RECORDS

CASING RECORD

FORMATION	CONTENT	FROM	TO	SIZE	PUT IN	PULLED OUT
				8 5/8	161'	None

Describe in detail the manner in which the well was plugged, indicating where the mud fluid was placed and the method or methods used in introducing it into the hole. If cement or other plugs were used, state the character of same and depth placed, from _____ feet to _____ feet for each plug set.

Filled hole with heavy drilling mud to 600', set plug, cemented with 20 sacks of cement.
Filled hole with heavy drilling mud to 150', set plug, cemented with 15 sacks of cement.
Filled hole with heavy drilling mud to 40', set plug, cemented with 10 sacks of cement to bottom of cellar.

(If additional description is necessary, use BACK of this sheet)

Name of Plugging Contractor Transit Corporation
Address 1516 Liberty Bank Building, Oklahoma City, Oklahoma

STATE OF Oklahoma, COUNTY OF Oklahoma, ss.
Paul E. Gathers (employee of owner) or (owner or operator) of the above-described well, being first duly sworn on oath, says: That I have knowledge of the facts, statements, and matters herein contained and the log of the above-described well as filed and that the same are true and correct. So help me God.

(Signature) Paul E. Gathers

(Address) _____

SUBSCRIBED AND SWORN TO before me this 24th day of July, 1958

My commission expires May 17, 1962

Mildred [Signature]
STATE CORPORATION Notary Public.

PLUGGING
FILE SEC 23T 10 R 19W
BOOK PAGE 113 LINE 18

JUL 26 1958
07-26-1958
CONSERVATION DIVISION

15-163-00760-00-00

DRILLER'S WELL LOG

Davis Bros.--Transit Corporation - Catudal "B" # 1 located in
NW SW NE Sec. 23-10S-19W,
Rooks County, Kansas

Commenced: June 21, 1958
Completed: June 3, 1958
Elevation: 2097' K.B.

Casing 8 5/8" @ 161'
Cemented 130 sacks

<u>Formation</u>	<u>From</u>	<u>To</u>
Surface clay and shale	0	133
Shale	133	161
Shale and shells	161	900
Sand	900	1120
Shale and shells	1120	1452
Anhydrite	1452	1478
Shale and shells	1478	2010
Shale and lime streaks	2010	2224
Lime and shale streaks	2224	2665
Shale and lime	2665	2765
Lime and shale	2765	3155
Lime	3155	3500
Shale and lime	3500	3559
Cherty, conglomerate and shale	3559	3593
Conglomerate	3593	3600
Simpson dolomite	3600	3630
Arbuckle lime	3630	3690 TD

Summary of Formation

Topeka	3043'
Heebner	3258'
Toronto	3277'
Douglas	3290'
Lansing	3298'
B/Kansas City	3525'
Conglomerate	3544'
Simpson	3596'
Arbuckle	3631'

I hereby certify the foregoing to be a true and accurate Driller's Log of the formation encountered in the above well.

Subscribed and sworn to before me
this 24th. day of July, 1958.

TRANSIT CORPORATION

By Paul E. Gathers

My Commission expires May 17, 1962.

Maude J. Brown

PLUGGING	
FILE SEC. 23 T. 10 R. 19W	
BOOK PAGE 113 LINE 18	

RECEIVED
STATE SUPERVISOR COMMISSION

JUL 26 1958
07-26-1958
CONSERVATION DIVISION
Wichita, Kansas