


Give All Information Completely
Make Required Affidavit
Mail or Deliver Report to:
Conservation Division
State Corporation Commission
800 Bittling Building
Wichita, Kansas

WELL PLUGGING RECORD

Rooks County. Sec. 12 Twp. 9 Rge. 19 (E) (W)
Location as "NE/CNW/SW" or footage from lines SW NW NE
Lease Owner W. E. Wickizer
Lease Name Thomas Jelinek Well No. 1
Office Address Wakeeney, Kansas
Character of Well (completed as Oil, Gas or Dry Hole) Oil Well
Date well completed October 1, 1952 19
Application for plugging filed January 17, 1955 19
Application for plugging approved January 18, 1955 19
Plugging commenced February 11, 1955 19
Plugging completed February 17, 1955 19
Reason for abandonment of well or producing formation oil depleted

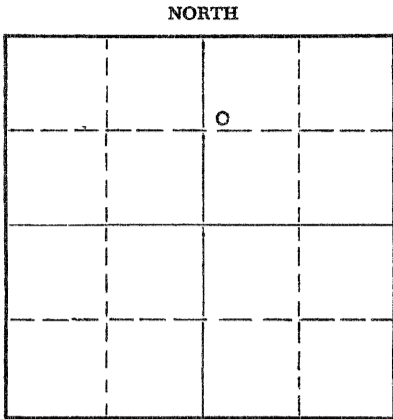

Locate well correctly on above Section Plat

If a producing well is abandoned, date of last production _____ 19
Was permission obtained from the Conservation Division or its agents before plugging was commenced? Yes

Name of Conservation Agent who supervised plugging of this well Eldon Petty
Producing formation _____ Depth to top _____ Bottom _____ Total Depth of Well 3484 Feet
Show depth and thickness of all water, oil and gas formations.

OIL, GAS OR WATER RECORDS

CASING RECORD

FORMATION	CONTENT	FROM	TO	SIZE	PUT IN	PULLED OUT
				8-5/8"	274'	None
				4-1/2"	3479	550'

Describe in detail the manner in which the well was plugged, indicating where the mud fluid was placed and the method or methods used in introducing it into the hole. If cement or other plugs were used, state the character of same and depth placed, from _____ feet to _____ feet for each plug set.

8 5/8" at 274 feet circulated with cement. 4-1/2" set at 3479 feet with 100 sax cement behind. Perforated at 3209 feet. Perforations squeezed off with cement. Filled with sand and set plug at 3190 feet. Set 4 sacks of cement with dump bailer, pulled 550 feet of 4-1/2". Filled hole with mud to 275 feet. Set rock and 15 sacks of cement. Mudded hole to 35 feet. Set rock and 10 sacks of cement to bottom of cellar.

(If additional description is necessary, use BACK of this sheet)

Name of Plugging Contractor Arnett Casing Pulling
Address Hoisington, Kansas

STATE OF KANSAS, COUNTY OF _____, ss.

(employee of owner) or (owner or operator) of the above-described well, being first duly sworn on oath, says: That I have knowledge of the facts, statements, and matters herein contained and the log of the above-described well as filed and that the same are true and correct. So help me God.

(Signature) W. E. Wickizer x

(Address) _____

SUBSCRIBED AND SWORN TO before me this 26th day of April, 1955

My commission expires 9-10-55 Joy H. Horak Notary Public.

PLUGGING
FILE SEC 12 T 9 R 19W
BOOK PAGE 91 LINE 35

RECEIVED
STATE CORPORATION COMMISSION
4/27/55
APR 27 1955
CONSERVATION DIVISION
Wichita, Kansas

15-163-00638-00-00

WELL LOG BUREAU—KANSAS GEOLOGICAL SOCIETY
508 East Murdock, Wichita, Kansas

Company- WICK PETROLEUM
Farm- Jelinek No. 1

SEC. 12 T 9 R. 19W
SW NW NE

Total Depth. 3485
Comm. 7-30-52 Comp. 10-1-52
Shot or Treated.
Contractor.
Issued. 11-28-53

County Books
KANSAS

CASING:

10" 163'
5" 3481'

Elevation. 2039

Production. Pmp 90 bbls. +
trace wtr.

Figures Indicate Bottom of Formations.

no drillers log to 3195

shale	3195-97
lime	3202
shale	3211
lime	3217
lime	3230
shale	3235
lime	3415
shale	3419
lime	3452
shale red	3459
lime	3466
shale	3474
lime	3478
dolo.	3485
Total Depth	

Tops:

Heebner	3195
Dodge	3211
Lansing-K.C.	3235
Arbuckle	3478

Ran Lane-Wells

D.S.T. # 1 3398-3411 Rec. 10'
rotary mud no blow open 20 mins.

2 3475-80 open 20 mins. rec.
3' rotary mud slight S.O.

3 3475-85 open 20 mins. rec.
18' fluid, est. 15' mud 3' free oil.

PLUGGING
FILE SEC 12 T 9 R 19W
BOOK PAGE 91 LINE 35

1/19/55