


WELL PLUGGING RECORD

Give All Information Completely
Make Required Affidavit
Mail or Deliver Report to:
Conservation Division
State Corporation Commission
800 Bitting Building
Wichita, Kansas

NORTH

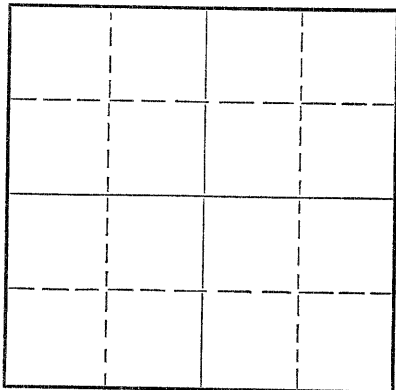

Locate well correctly on above
Section Plat

Rooks County. Sec. 12 Twp. 9 Rge. 19 (E) W (W)
Location as "NE/CNW $\frac{1}{4}$ SW $\frac{1}{4}$ " or footage from lines SE NE SW
Lease Owner Trans Era Petroleum, Inc.
Lease Name Hilgers "C" Well No. 1
Office Address Russell, Kansas
Character of Well (completed as Oil, Gas or Dry Hole) Dry
Date well completed 10/15/52 19
Application for plugging filed 11/13/52 19
Application for plugging approved 11/13/52 19
Plugging commenced 11/14/52 19
Plugging completed 11/22/52 19
Reason for abandonment of well or producing formation Dry

If a producing well is abandoned, date of last production 19
Was permission obtained from the Conservation Division or its agents before plugging was commenced? Yes

Name of Conservation Agent who supervised plugging of this well Eldon Petty
Producing formation Depth to top Bottom Total Depth of Well 3493 Feet
Show depth and thickness of all water, oil and gas formations.

OIL, GAS OR WATER RECORDS

CASING RECORD

Formation	Content	From	To	Size	Put In	Pulled Out
				8 5/8"	217	None
				5 1/2"	3481	2723

Describe in detail the manner in which the well was plugged, indicating where the mud fluid was placed and the method or methods used in introducing it into the hole. If cement or other plugs were used, state the character of same and depth placed, from feet to feet for each plug set.

PLUGGING RECORD

Plugged back with crushed rock from 3528' to 3290'. Dumped 5 sax cement with dump bailer at 3290'. Top of cement 3255'. Pulled hole with mud to 217', set rock bridge, dumped 15 sax cement. Top of cement 170', filled hole with mud to 35', set rock bridge, dumped 10 sax cement for cap.

(If additional description is necessary, use BACK of this sheet)
Name of Plugging Contractor Miller Casing Pulling
Address Russell Great Bend, Kansas

OF KANSAS, COUNTY OF RUSSELL, ss.
Herbert R. Michaelis (employee of owner) or (owner or operator) of the above-described well,
do hereby swear on oath, says: That I have knowledge of the facts, statements, and matters herein contained and the log of the above-
described well as filed and that the same are true and correct. So help me God.

(Signature) *H.R. Michaelis*
Russell, Kansas (Address)

DEPOSED AND SWORN TO before me this 2nd day of December, 1952

Expires 6-17-54.

Stan [Signature]
Notary Public.

PLUGGING
FILE SEC 12 T 9 R 19
BOOK PAGE 61 LINE 40

6-51-20M
STATE CORPORATION COMMISSION
12/3/52
DTC - 3 1952
CONSERVATION DIVISION
Wichita, Kansas

Trans Era Petroleum, Inc.
Hilgers "C" #1

SE NE SW 12-9-19W
Rooks County, Kans.

Total Depth: 3493'
Comm. 9/17/52
Comp. 10/15/52

Casing

8 5/8" Set @ 217
5 1/2" Set @ 3481

Cement

135 sacks Lone Star
100 sacks Victor

Formation

Depth

Clay-sand	100
Shale-shells	150
Shale	240
Shells-sand-shale	835
Shale-shells	950
Sand	1150
Shale	1165
Shale-red bed	1425
Anhydrite	1465
Shale-shells	1910
Lime-shale	2950
Lime	3040
Shale-lime	3143
Lime	3200
Shale-lime	3272
Lime	3457
Shale-lime	3493'

STATE OF KANSAS)
) ss
RUSSELL COUNTY)

I hereby certify that the above information is true and correct to the best of my knowledge.

Cora Betty

Subscribed and sworn to before me this 2nd day of December, 1952.

Marshall

Notary Public

My commission expires: 6-17-54.

