

STATE OF KANSAS
STATE CORPORATION COMMISSION


WELL PLUGGING RECORD

Give All Information Completely
Make Required Affidavit
Mail or Deliver Report to:
Conservation Division
State Corporation Commission
800 Bitting Building
Wichita, Kansas

OR
FORMATION PLUGGING RECORD

Strike out upper line
when reporting plugging
off formations.

NORTH

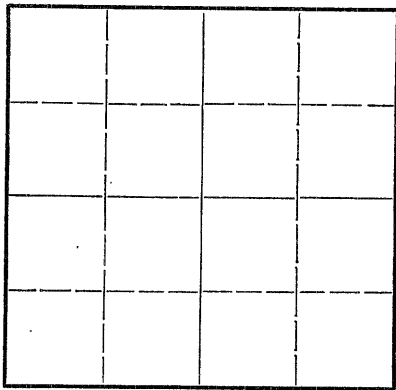

Locate well correctly on above
Section Plat

Rooks County. Sec. 12 Twp. 9 Rge. (E) 19(W)
Location as "NE 1/4 NW 1/4 SW 1/4" or footage from lines. SEC NE
Lease Owner D. R. Lauck et. al
Lease Name Jelinek Well No. 1
Office Address 520 Fourth Nat'l Bank Bldg. Wichita 2 Kans
Character of Well (completed as Oil, Gas or Dry Hole) dry hole
Date well completed May 28th 19 47
Application for plugging filed May 28th 19 47
Application for plugging approved May 28th 19 47
Plugging commenced May 28th 19 47
Plugging completed May 28th 19 47
Reason for abandonment of well or producing formation
no oil or gas
If a producing well is abandoned, date of last production 19

Name of Conservation Agent who supervised plugging of this well C. D. Stough
Producing formation none Depth to top Bottom Total Depth of Well 3643 Feet

Show depth and thickness of all water, oil and gas formations.


OIL, GAS OR WATER RECORDS

CASING RECORD

| Formation | Content | From | To | Size | Put In | Pulled Out |
|-----------|---------|------|------|------|--------|---------------|
| Arbuckle | water | 3605 | 3644 | 10" | 219' | none-cemented |
| | | | | | | |
| | | | | | | |
Describe in detail the manner in which the well was plugged, indicating where the mud fluid was placed and the method or methods used in introducing it into the hole. If cement or other plugs were used, state the character of same and depth placed, from feet to feet for each plug set.

| | |
|-----------|-----------------------|
| Heavy mud | 3644 - 218 |
| Bridge | 218 - 214 |
| Cement | 214 - 175 |
| Heavy mud | 175 - 35 |
| Bridge | 35 - 30 |
| Cement | 30 - bottom of cellar |

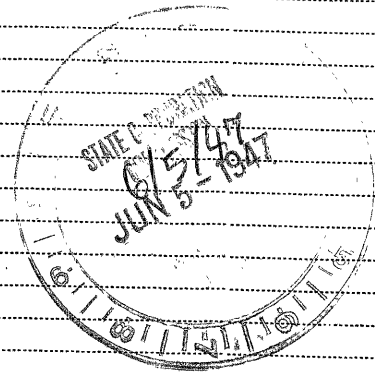

(If additional description is necessary, use BACK of this sheet)

Correspondence regarding this well should be addressed to D. R. Lauck
Address 520 Fourth Nat'l Bank Building Wichita 2 Kansas.

STATE OF Kansas, COUNTY OF Sedgwick, ss.

E. C. Moncrief (employee of owner) or (owner or operator) of the above-described well,
being first duly sworn on oath, says: That I have knowledge of the facts, statements, and matters herein contained and the log of the above-described well as filed and that the same are true and correct. So help me God.

(Signature) E. C. Moncrief
Wichita, Kansas (Address)

SUBSCRIBED AND SWORN to before me this 4 day of June, 19 47

My commission expires Sept. 14, 1947

Elizabeth Gay
Notary Public.

PLUGGING
FILE SEC 12 T 9 R 19W
BOOK PAGE 111 LINE 42

15-163-02900-00-00

D. R. LAUCK et.al.

#1 Jelinek

Sec. 12 T9S R19W

SEc NE $\frac{1}{4}$

Commenced May 14, 1947

Completed May 28, 1947

Casing:

10" 219' cemented 150 sacks

| | |
|----------------|------|
| Sand & shale | 170 |
| Shale | 200 |
| shale & shells | 960 |
| shale & sand | 1010 |
| shale & shells | 1385 |
| Anhydrite | 1410 |
| shale | 1445 |
| lime | 1485 |
| shale & shells | 2305 |
| shale & lime | 2645 |
| shale & shells | 2710 |
| shale & lime | 3160 |
| lime | 3644 |

D & A

Tops - Derrick floor

| | |
|--------------|------|
| Topeka | 3003 |
| Heebner | 3210 |
| Lansing | 3250 |
| Conglomerate | 3549 |

| | |
|-------------------|------|
| Reworked Arbuckle | 3605 |
| Solid Arbuckle | 3638 |
| Total Depth | 3643 |

Drill stem test 3423-38
10' mud in 30 minutes

PLUGGING
 FILE SEC 12 T 9 R 19W
 BOOK PAGE 111 LINE 42

6/5/47
 LIN 5