


WELL PLUGGING RECORD

Give All Information Completely  
Make Required Affidavit  
Mail or Deliver Report to:  
Conservation Division  
State Corporation Commission  
212 No. Market  
Wichita, Kansas

NORTH

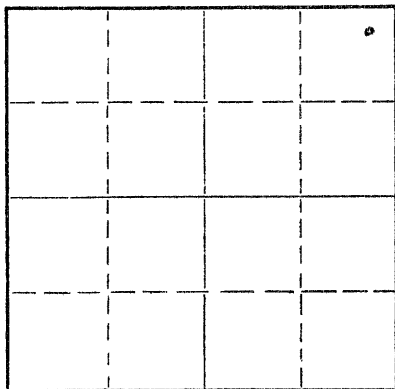

Locate well correctly on above  
Section Plat

Rooks County. Sec. 26 Twp. 9 Rge. (E) 19 (W)

Location as "NE/CNW/SW" or footage from lines NE NE NE

Lease Owner Four-Way Operating, Inc.

Lease Name Benoit Well No. 1

Office Address Box 698, Great Bend, Kansas

Character of Well (completed as Oil, Gas or Dry Hole) oil

Date well completed 19

Application for plugging filed June 15 19 67

Application for plugging approved 19

Plugging commenced June 19 19 67

Plugging completed June 23 19 67

Reason for abandonment of well or producing formation depleted

If a producing well is abandoned, date of last production 19

Was permission obtained from the Conservation Division or its agents before plugging was commenced? yes

Name of Conservation Agent who supervised plugging of this well Leo F. Massey

Producing formation Depth to top Bottom Total Depth of Well 3582 Feet

Show depth and thickness of all water, oil and gas formations.

OIL, GAS OR WATER RECORDS

CASING RECORD

FORMATION	CONTENT	FROM	TO	SIZE	PUT IN	PULLED OUT
		0	238'	8 5/8"	238'	none
		0	3577'	5 1/2"	3577'	845.20

Describe in detail the manner in which the well was plugged, indicating where the mud fluid was placed and the method or methods used in introducing it into the hole. If cement or other plugs were used, state the character of same and depth placed, from feet to feet for each plug set.

Pushed plug to 3300', set 10' rock bridge and dumped 5 sacks of cement.

Squeezed with 20 sacks of mud and 60 sacks of cement to top.

RECEIVED  
STATE CORPORATION COMMISSION  
JUL 6 1967  
CONSERVATION DIVISION  
Wichita, Kansas

(If additional description is necessary, use BACK of this sheet)  
Name of Plugging Contractor Pipe Pullers, Inc.  
Address Box 486, Ellinwood, Kansas

STATE OF Kansas, COUNTY OF Barton, ss.  
Dean Wells (employee of owner) or (owner or operator) of the above-described

well, being first duly sworn on oath, says: That I have knowledge of the facts, statements, and matters herein contained and the log of the above-described well as filed and that the same are true and correct. So help me God.

(Signature) [Signature] Ellinwood, Kansas (Address)

SUBSCRIBED AND SWORN TO before me this 27th day of June, 19 67

My commission expires July 7, 1968 [Signature] Notary Public.

DRILLING LOG

To: Gray Petroleum Corporation,  
Main Building,  
Wichita 2, Kansas.

Lease: STRIP #1:

County: Rooks, Kansas.  
Section: 26 - 9 - 19W,  
Location: NE/4 NE/4 NE/4

Jobby: Total Depth - 3,582'  
Commenced: Dec. 11, 1948; Completed: Dec. 31, 1948  
Shot or Treated:  
Casing: 230' of 3-5/8": 3,582' of 5 1/2"

Contractor: L-S-F Drilling Co., Inc.,  
1316 Union National Bank Building,  
Wichita 2, Kansas.

FIGURES INDICATE BOTTOM OF FORMATION:

0	To	225	Clay, Sand & Shale
225		375	Shale & Shells
375		960	Sand & Shale
960		1,020	Shale
1,020		1,330	Sand & Shale
1,330		1,384	Shale, Lime & Shells
1,384		1,440	Red Bed & Shells
1,440		1,568	Anhydrite
1,568		1,775	Shale & Shells
1,775		2,070	Sand & Lime
2,070		2,300	Lime & Shale
2,300		2,795	Lime
2,795		2,810	Lime
2,810		3,351	Lime
3,351		3,370	Coarse Sand
3,370		3,582	T.D. Sand

STATE OF KANSAS

SS:

COUNTY OF S. DEWICK

I, the undersigned, being duly sworn on oath, depose that the above  
report and log are true and correct as recorded and log of the well drilled at  
the location above described.

L-S-F Drilling Co., Inc.

*W. H. Winkley*

Subscribed and sworn to before me this 11th day of December, 1948.

*W. H. Winkley*  
Public