


STATE OF KANSAS
STATE CORPORATION COMMISSION

WELL PLUGGING RECORD

Give All Information Completely
Make Required Affidavit
Mail or Deliver Report to:
Conservation Division
State Corporation Commission
800 Bitting Building
Wichita, Kansas

NORTH

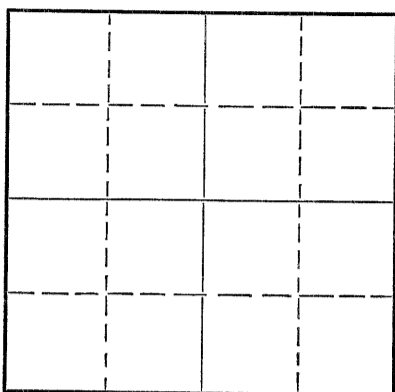

Locate well correctly on above
Section Plat

Rooks County. Sec. 26 Twp. 9 Rge. 19 (W)
Location as "NE/CNW $\frac{1}{4}$ SW $\frac{1}{4}$ " or footage from lines NW NW NE
Lease Owner Petroleum, Inc.
Lease Name Jelinek Well No. 1
Office Address 100 Derby Bldg., Wichita, Ks.
Character of Well (completed as Oil, Gas or Dry Hole) Oil
Date well completed November 30, 1950
Application for plugging filed October 16, 1951
Application for plugging approved October 16, 1951
Plugging commenced October 16, 1951
Plugging completed October 16, 1951
Reason for abandonment of well or producing formation
Production Depleted
If a producing well is abandoned, date of last production September 1951
Was permission obtained from the Conservation Division or its agents before plugging was commenced? Yes

Name of Conservation Agent who supervised plugging of this well Mr. Eldon Petty, Hays, Kansas
Producing formation Arbuckle Depth to top 3554 Bottom Total Depth of Well 3558 Feet
Show depth and thickness of all water, oil and gas formations.

OIL, GAS OR WATER RECORDS

CASING RECORD

Formation	Content	From	To	Size	Put In	Pulled Out
				8 5/8"	180'	None
				5 1/2"	3555'	2900'

Describe in detail the manner in which the well was plugged, indicating where the mud fluid was placed and the method or methods used in introducing it into the hole. If cement or other plugs were used, state the character of same and depth placed, from feet to feet for each plug set.

Filled with chet to 3550'. Placed 4
sacks cement at 3550'. Mudded up to
181' and placed rock bridge at 181'.
Placed 15 sacks cement on top of rock
bridge; then mudded up to 35' and placed
second rock bridge at 35'. Filled hole
with 10 sacks cement.

(If additional description is necessary, use BACK of this sheet)

Correspondence regarding this well should be addressed to Petroleum, Inc.
Address 100 Derby Bldg., Wichita 2, Kansas

STATE OF KANSAS, COUNTY OF SEDGWICK, ss.
Eric H. Jager (employee of owner or owner or operator)

being first duly sworn on oath, says: That I have knowledge of the facts, statements, and matters herein contained and the log of the above-described well as filed and that the same are true and correct. So help me God.

(Signature) Eric H. Jager
100 Derby Bldg., Wichita 2, Kansas
(Address)

SUBSCRIBED AND SWORN to before me this 17th day of October, 1951

Charlotta Weidman
Notary Public.

My commission expires October 13, 1954

28-5091-s

8-50-10M

PLUGGING
FILE SEC 25 T 9 R 19 W
BOOK PAGE 47 LINE 36

10/19/51
OCT 19 1951
CONSERVATION DIVISION
WICHITA, KANSAS

COMPANY: PETROLEUM, INC. Rotary Drilling Commenced: 11-21-50
 Wichita, Kansas Rotary Drilling Completed: 11-30-50

LOCATION: JELINEK #1, NW NW NE, Sec. 26-9S-19W
 Rocks County, Kansas

CONTRACTOR: PICKRELL DRILLING COMPANY, INC.
 Wichita, Kansas

CASING RECORD: 180' (6 Jts.) 8 5/8" 24# seamless casing set at 180' in a 12 1/4" hole, cemented with 100 sack cement.

3555' (112 Jts.) 5 1/2" casing set at 3555' in a 7 7/8" hole, cemented with 100 sacks cement.

LOG

(Figures indicate bottom formation - measurements from top rotary bushing.)

Cellar	5	Circulate for samples at 3380'.
Surface Rock & Shale	40	" " " " 3558'.
Shale & Shells	975	
Sand	1225	Slope test at 500' - 0° off.
Shale & Sand Strs.	1500	" " " 1000' - 0° off.
Anhydrite	1538	" " " 1500' - 0° off.
Shale & Shells	2175	S.L.M. at 1500' - O.K.
Lime & Shale Str.	2290	Slope test at 2000' - 0° off.
Lime	2415	" " " 2500' - 0° off.
Bro. Lime & Shale	2515	" " " 3000' - 0° off.
Lime & Shale	2670	" " " 3500' - 0° off.
Lime Str. & Shale	2780	S.L.M. at 3558' - O.K.
Lime	3045	
Lime & Shale Str.	3130	Lost Circulation at 3088'.
Lime	3240	" " " 3092'.
Lime & Shale	3325	
Lime	3554	
Arbuckle	3558 Rotary T.D.	

The undersigned, C. W. Sebitts, Secretary of PICKRELL DRILLING COMPANY, INC., hereby certifies in behalf of said corporation, that the above log is a true and correct log of the formation encountered in drilling the above well as reflected by the Daily Drilling Reports.

PICKRELL DRILLING COMPANY, INC.
 By: [Signature]
 Secretary

STATE OF KANSAS)
) SS
 COUNTY OF SEDGWICK)

BE IT REMEMBERED that on this 8th day of December, 1950, before me, the undersigned, a Notary Public, duly commissioned, in and for the county and state aforesaid, came C. W. Sebitts, Secretary of Pickrell Drilling Company, Inc., a corporation of the State of Kansas, personally known to me to be such officer, and to be the same person who executed as such officer the foregoing instrument of writing in behalf of said corporation, and he duly acknowledged the execution of the same for himself and for said corporation.

IN WITNESS WHEREOF, I have hereunto set my hand and official seal on the day and year last above written.

[Signature]
 Notary Public

My commission expires January 28, 1953.

PLUGGING
 FILE 2519-19W
 BOOK PAGE 117 LINE 36