


15-163-01031-00-00

STATE OF KANSAS
STATE CORPORATION COMMISSION

WELL PLUGGING RECORD

Give All Information Completely
Make Required Affidavit
Mail or Deliver Report to:
Conservation Division
State Corporation Commission
800 Bitting Building
Wichita, Kansas

NORTH

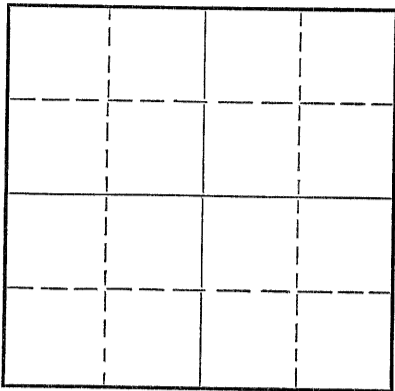

Locate well correctly on above
Section Plat

Rooks County. Sec. 27 Twp. 9 Rge. (E) 19 (W) 19
Location as "NE/CNW $\frac{1}{4}$ SW $\frac{1}{4}$ " or footage from lines 330'N 990'W of E/4 Corner
Lease Owner Cities Service Oil Company
Lease Name Bartos Well No. 4
Office Address Bartlesville, Oklahoma
Character of Well (completed as Oil, Gas or Dry Hole) Dry Hole
Date well completed 3-24 19 56
Application for plugging filed 3-24 19 56
Application for plugging approved 3-24 19 56
Plugging commenced 3-24 19 56
Plugging completed 3-24 19 56
Reason for abandonment of well or producing formation _____

If a producing well is abandoned, date of last production _____ 19 ____
Was permission obtained from the Conservation Division or its agents before plugging was commenced? Yes

Name of Conservation Agent who supervised plugging of this well Mr. Eldon Petty
Producing formation Arbuckle Lime Depth to top 3622 Bottom _____ Total Depth of Well 3655 Feet
Show depth and thickness of all water, oil and gas formations.

OIL, GAS OR WATER RECORDS

CASING RECORD

Formation	Content	From	To	Size	Put In	Pulled Out
<u>Arbuckle Lime</u>	<u>Dry</u>			<u>85/8</u>	<u>240'</u>	<u>None</u>

Describe in detail the manner in which the well was plugged, indicating where the mud fluid was placed and the method or methods used in introducing it into the hole. If cement or other plugs were used, state the character of same and depth placed, from _____ feet to _____ feet for each plug set.

Filled hole with heavy mud from 3655' to 230', set wood plug with one half sack hulls, ran 15 sacks cement, filled hole with heavy mud to 40' set wood plug with one half sack hulls ran 10 sacks cement, filled to bottom of cellar, mud and dirt to surface.

Name of Plugging Contractor Lohman-Johnson (If additional description is necessary, use BACK of this sheet)
Address Evansville, Indiana

STATE OF Kansas COUNTY OF Barton, ss.
R. J. Turner (employee of owner) or (~~owner of property~~) of the above-described well,

being first duly sworn on oath, says: That I have knowledge of the facts, statements, and matters herein contained and the log of the above-described well as filed and that the same are true and correct. So help me God.
(Signature) R. J. Turner

Box 553 Russell, Kansas
(Address)

SUBSCRIBED AND SWORN to before me this 29th day of March, 1956

My commission expires March 17, 1959

23-8390-s 6-51-20M

W. G. Smith
Notary Public.

PLUGGING
FILE SEC 27 T 9 R 19 W
BOOK PAGE 48 LINE 33

APR 1 1956
WICHITA, KANSAS

WELL RECORD

Company Cities Service Oil Company Well No. A Farm Bartos
 Location 330' North and 990' West of E/4 Cor. Sec. 27 T. 9 R. 19W
 Elevation 2192 (2189 Cr.) County Rock State Kansas
 Drlg. Comm. March 13, 1956 Contractor Lohmann-Johnson Drlg. Co., Inc.
 Drlg. Comp. March 24, 1956 Acid None
 T. D. 3655' Initial Prod. Dry Hole - P. & A. 3-24-56

CASING RECORD:

8-5/8" @ 240' con. 175 sz cement

FORMATION RECORD:

sand & shale	0-240
shale	390
shale & sand	1240
shale & shells	1540
anhydrite	1580
shale	1588
shale & shells	2024
lime	2148
lime & shale	2285
lime	2450
lime & shale	2749
lime	2815
lime & shale	2960
shale & lime	3228
lime	3624
chert & lime	3628
lime	3655 T. D.

Topeka	3103'
Hoehner	3341'
Dodge	3361'
Lansing	3380'
Conglomerate	3610'
Residual Arbuckle	3619'
Arbuckle	3622'
Penetration	33'
Total Depth	3655'

D. S. T. 3372-3417, open 1 hr., recovered 65' slightly oil-out watery mud; B. H. P. 995#/30 mins.

D. S. T. 3449-86, open 1 hr., recovered 1365' salt water; B. H. P. 825#/30 mins.

D. S. T. 3498-3527, open 30 mins., recovered 12' mud; B. H. P. 155#/30 mins.

D. S. T. 3543-70, open 30 mins., recovered 8' mud; B. H. P. 0#/30 mins.

D. S. T. 3622-28, open 30 mins., recovered 42' thin mud; B. H. P. 800#/30 mins.

D. S. T. 3627-33, open 30 mins., recovered 10' mud with few specks oil; B. H. P. 550#/30 mins.

SLOPE TESTS (SIFO):

500'	0°
8000'	1°
1500'	2°
2000'	0°
2500'	1°
3000'	1°

7-7/8" rotary hole.

PLUGGING

FILE SEC 27 T 9 R 19W
 BOOK PAGE 48 LINE 33