

STATE OF KANSAS
STATE CORPORATION COMMISSION
200 Colorado Derby Building
Wichita, Kansas 67202

WELL PLUGGING RECORD
K.A.R.-82-3-117

API NUMBER _____

LEASE NAME HinmanWELL NUMBER 2

_____ Ft. from S Section Line

_____ Ft. from E Section Line

SEC. 23 TWP. 9S RGE. 21W (~~E~~ or W)COUNTY Graham

Date Well Completed _____

Plugging Commenced 7-23-90Plugging Completed 9-13-90

TYPE OR PRINT
NOTICE: Fill out completely
and return to Cons. Div.
office within 30 days.

LEASE OPERATOR Phillips Petroleum CompanyADDRESS RT #3 Box 20-A Great Bend, KS. 67530PHONE#(316) 793-8421 OPERATORS LICENSE NO. 5229Character of Well Oil

(Oil, Gas, D&A, SWD, Input, Water Supply Well)

The plugging proposal was approved on _____ (date)

by _____ (KCC District Agent's Name).

Is ACO-1 filled? _____ If not, Is well log attached? _____

Producing Formation _____ Depth to Top _____ Bottom _____ T.D. 3817'

Show depth and thickness of all water, oil and gas formations.

OIL, GAS OR WATER RECORDS

CASING RECORD

Formation	Content	From	To	Size	Put in	Pulled out
				10 3/4"	240'	none
				6"	3809'	none

Describe in detail the manner in which the well was plugged, indicating where the mud fluid was placed and the method or methods used in introducing it into the hole. If cement or other plugs were used, state the character of same and depth placed, from _____ feet to _____ feet each set.
Sanded bottom to 3425', ran 5 sacks cement. Shot @2000', 1600',
1400', 1200', 1000'. Down 6" casing @600# Max Pressure mixed
4 sacks hulls with 325 sacks cement and shut in @300#. Filled
10 3/4" to surface with 75 sacks cement with 1 sack hulls and it communicated
(if additional description is necessary, use BACK of this form.) to 6" casing.

Name of Plugging Contractor KELSO CASING PULLING, INC. License No. 6050Address P.O. Box 347 Chase, Kansas 67524NAME OF PARTY RESPONSIBLE FOR PLUGGING FEES: Phillips Petroleum CompanySTATE OF Kansas COUNTY OF Rice, ss.

R. Darrell Kelso (Employee of Operator) or (Operator) of

above-described well, being first duly sworn on oath, says: That I have knowledge of the facts, statements, and matters herein contained and the log of the above-described well as filed that the same are true and correct, so help me God.


(Signature) R. Darrell Kelso(Address) P.O. Box 347 Chase, KS. 67524

RECEIVED
STATE CORPORATION COMMISSION

SUBSCRIBED AND SWORN before me this 5 day of Oct., 19 90

10-8-90


My Commission Expires: _____

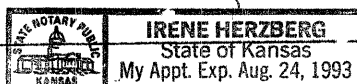

Notary Public

WELL SCHEMATIC

GL 2291'
KB 2296'
PBTD 3817'
TD 3817'

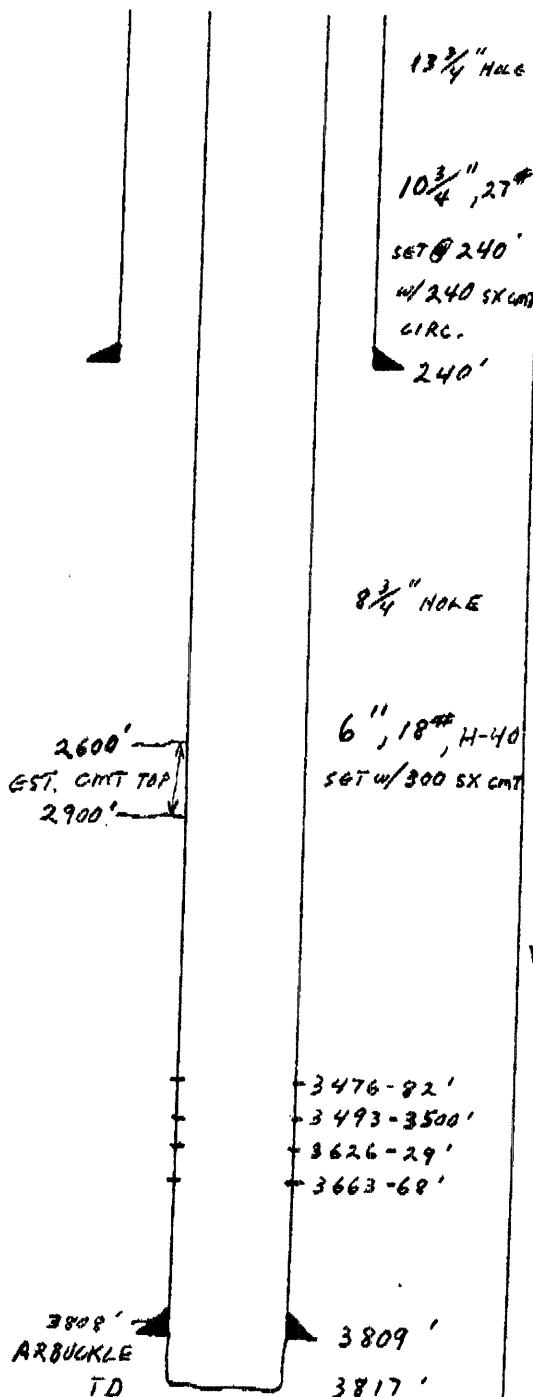

WELL DATA

WELL
LOCATION

HINMAN NO. 2 STATUS SD 016
2310' EST. + 2310' P.W.L. NE NE SW
SEC 23 - T9S - R 21W
GRANHAM COUNTY, KANSAS
12-7-45
1-10-46
759 ARL 016 PER DAY

CASING

OD	WT	GRADE	FROM	TO
10 3/4"	27#	SET @ 240' w/ 740 S&CMT, CIRC.		

6" 18" H⁴⁰ SET @ 3809' w/300 SX GmT

TUBING

PERFS.

ZONE	TYPE	INTERVAL	SPF
TORONTO		3476-82'	
LKE A		3492-3500'	
LKE H		3626-29'	
LKE J		3663-68'	
ARBuckle		3809-17'	

LOGS

[illegible]

WELL TEST

[illegible]

PREPARED BY: DAR

DATE: 3/29/90

1000