

WELL PLUGGING RECORD


STATE OF KANSAS STATE CORPORATION COMMISSION

Give All Information Completely Make Required Affidavit Mail or Deliver Report to: Conservation Division State Corporation Commission 800 Bittling Building Wichita, Kansas

OR FORMATION PLUGGING RECORD

Strike out upper line when reporting plugging of formations.

NORTH

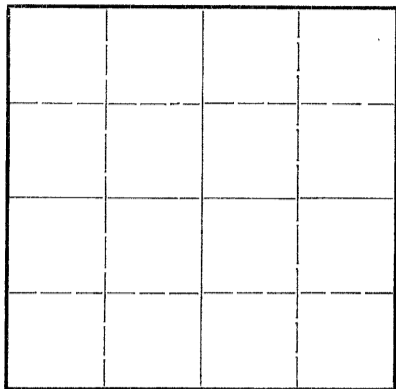

Locate well correctly on above Section Plat

Graham County. Sec. 23 Twp. 9S Rge. 21 (#) W (W) Location as "NE 1/4 NW 1/4 SW 1/4" or footage from lines SE 1/4 NE 1/4 NW 1/4 Lease Owner Continental Oil Company Lease Name Putman Investment Co. "A" Well No. 4 Office Address P.O. Box 1267 Ponca City, Oklahoma Character of Well (completed as Oil, Gas or Dry Hole) Dry Hole Date well completed October 2 19 44 Application for plugging filed October 30 19 44 Application for plugging approved October 3 19 44 Plugging commenced October 4 19 44 Plugging completed October 4 19 44 Reason for abandonment of well or producing formation Dry Hole

If a producing well is abandoned, date of last production No production 19. Was permission obtained from the Conservation Division or its agents before plugging was commenced? Yes

Name of Conservation Agent who supervised plugging of this well Mr. H.W. Kerr Great Bend, Kansas Producing formation Arbuckle Lime Depth to top 3802' Bottom 3809' Total Depth of Well 3809 Feet Show depth and thickness of all water, oil and gas formations.

OIL, GAS OR WATER RECORDS

CASING RECORD

Table with 7 columns: Formation, Content, From, To, Size, Put In, Pulled Out. Row 1: Surface casing, 10 3/4", 244' 2", none

Describe in detail the manner in which the well was plugged, indicating where the mud fluid was placed and the method or methods used in introducing it into the hold. If cement or other plugs were used, state the character of same and depth placed, from feet to feet for each plug set.

Hole was filled with heavy mud to within 240' of the top where a wood plug was set and cemented with 15 sacks of cement; the hole was then filled to within 25' of the top where a second wood plug was set and capped with 10 sacks of cement.

Handwritten notes: 23 9 21W, 134 20

(If additional description is necessary, use BACK of this sheet)

Correspondence regarding this well should be addressed to Mr. F.L. Dunn Address R.F.D. #4 Lyons, Kansas

STATE OF Kansas, COUNTY OF Rice, ss.

Mr. F.L. Dunn (employee of owner) or (owner or operator) of the above-described well, being first duly sworn on oath, says: That I have knowledge of the facts, statements, and matters herein contained and the log of the above-described well as filed and that the same are true and correct. So help me God.

(Signature) F.L. Dunn R.F.D. #4 Lyons, Kansas (Address)

SUBSCRIBED AND SWORN to before me this 30th day of October

My commission expires October 21st, 1948

Notary Public signature and seal

H E L L R E C O R D

Putman Investment Co. "A" No. 4

Date Spudded: Sept. 18, 1944
 Drig. Completed: October 3, 1944
 Date Plugged: October 4, 1944

Loc: 990'S and 330'W of N/4
 corner of Sec. 23, T9S, R11W,
 Graham County, Kansas

FROM	TO	FORMATION	FROM	TO	FORMATION
0	97	Surface soil & shale	2790	2825	Lime
97	603	Shale & shells	2825	3222	Lime & shale
603	1287	Sand & shale	3222	3260	Lime
1287	1732	Shale & shells	3260	3340	Lime & shale
1732	1800	Anhydrite	3340	3404	Broken lime
1800	2027	Shale & shells	3404	3444	Lime
2027	2187	Lime & shale & shells	3444	3551	Lime & shale
2187	2300	Shale & shells	3551	3611	Lime
2300	2402	Lime & shale	3611	3662	Lime & shale
2402	2480	Lime	3662	3743	Lime
2480	2562	Shale & shells	3743	3781	Cherty lime
2562	2790	Lime & shale	3781	3809	Lime

Elevation 2278'

Top of Kansas City Lime 3461'

Top of Arbuckle Lime 2802'

Ran 344'2" of 10 3/4" OD 40/ SVT Seamless casing; set at 339'; cemented with 240 sacks of Monarch Portland cement (Halliburton method).

Drilled to 3804' in Arbuckle Lime.

Cored from 2804' to 3809' in Arbuckle Lime, recovering 2' - top 3' shale and bottom 2' dolomite; no commercial show of oil.

Total depth 3809' in Arbuckle Lime.

10/4/44 - Plugged and abandoned.

Note: Footages calculated from ground level.

I, the undersigned, being first duly sworn upon oath, state that this well record is true, correct and complete according to the records of this office and to the best of my knowledge and belief.

F. L. Dun
 Assistant District Superintendent

Subscribed and sworn to before me this 26th day of October, 1944.

Louis M. Swire
 Notary Public

My commission expires October 31st, 1946.

and-EPB
 10-26-44
 LFD 5
 File
 Corp. Comm.

23 9 21W
 134 20

