


STATE OF KANSAS
STATE CORPORATION COMMISSION

Give All Information Completely
Make Required Affidavit
Mail or Deliver Report to:
Conservation Division
State Corporation Commission
212 North Market, Insurance Bldg.
Wichita, Kansas

WELL PLUGGING RECORD

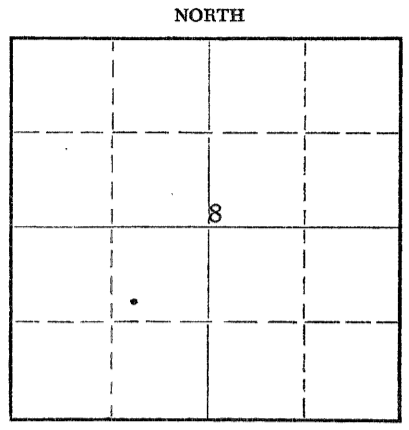

Locate well correctly on above Section Plat

Rooks County. Sec. 8 Twp. 9 Rge. 19 (E) (W)
Location as "NE/CNW/SW" or footage from lines SW NE SW
Lease Owner Nadel and Gussman
Lease Name Stull #1 Well No. _____
Office Address 625 Union Center Building, Wichita, Kansas
Character of Well (completed as Oil, Gas or Dry Hole) Dryhole
Date well completed August 15 19 60
Application for plugging filed August 15 19 60
Application for plugging approved August 15 19 60
Plugging commenced August 15 19 60
Plugging completed August 15 19 60
Reason for abandonment of well or producing formation Dryhole

If a producing well is abandoned, date of last production _____ 19____
Was permission obtained from the Conservation Division or its agents before plugging was commenced? Yes

Name of Conservation Agent who supervised plugging of this well Eddon Petty
Producing formation _____ Depth to top _____ Bottom _____ Total Depth of Well 3550 Feet
Show depth and thickness of all water, oil and gas formations.

OIL, GAS OR WATER RECORDS

CASING RECORD

| FORMATION | CONTENT | FROM | TO | SIZE | PUT IN | PULLED OUT |
|-----------|---------|------|----|-------|--------|------------|
| | | | | 8 3/8 | 2 1/2" | 0 |
| | | | | | | |
| | | | | | | |
Describe in detail the manner in which the well was plugged, indicating where the mud fluid was placed and the method or methods used in introducing it into the hole. If cement or other plugs were used, state the character of same and depth placed, from _____ feet to _____ feet for each plug set.

Cemented with 20 sacks of cement at 600'
Cemented with 20 sacks of cement at 180'
10 sacks of cement and 1/2 sack of hulls at 40'

RECEIVED
STATE CORPORATION COMMISSION

SEP 20 1960
9-20-60
CONSERVATION DIVISION
Wichita, Kansas

(If additional description is necessary, use BACK of this sheet)

Name of Plugging Contractor Jones Drilling Company
Address Great Bend, Kansas

STATE OF Kansas, COUNTY OF Barton, ss.
A. M. Jones (employee of owner) or (owner or operator) of the above-described well, being first duly sworn on oath, says: That I have knowledge of the facts, statements, and matters herein contained and the log of the above-described well as filed and that the same are true and correct. So help me God.

(Signature) A M Jones
Great Bend, Kansas
(Address)

SUBSCRIBED AND SWORN TO before me this 30th day of August, 19 60

My commission expires April 11, 1963
John W. Poos Notary Public.



Date started 8-7-60
Date completed 8-15-60

Stull #1
SW/4 NE/4 SW/4
Sec. 8-9-19
Rooks County, Kansas

Anhydrite 1471'
Heebner 3209'
Kansas City 3253'
Arbuckle 3514'

Total Depth 3550'

0' - 217' Limestone, shale
217' - 740' Shale and shell
740' - 970' Shale
970' - 1180' Sand
1180' - 1471' Redbed and shale
1471' - 1510' Anhydrite
1510' - 1970' Shale and shell
1970' - 3320' Lime and shale
3320' - 3410' Lime
3410' - 3520' Lime and shale
3520' - 3527' Lime
3527' - 3550' Lime and chert

RECEIVED
STATE CORPORATION COMMISSION
SEP 20 1960
9-20-60
CONSERVATION DIVISION
Wichita, Kansas

AFFIDAVIT

State of Kansas County of Barton

I, A. M. Jones, certify that the above is a true and correct log as reflected by the Daily Drilling Reports of the Jones Drilling Company.

By: *A. M. Jones*
A. M. Jones, Owner

Subscribed and sworn before me this 30th Day of August, 1960.

John W. Poes
John W. Poes Notary Public

My commission expires April 11, 1963.