


STATE OF KANSAS
CORPORATION COMMISSION

Give All Information Completely
Make Required Affidavit
Mail or Deliver Report to:
Conservation Division
State Corporation Commission
800 Biting Building
Wichita, Kansas

WELL PLUGGING RECORD

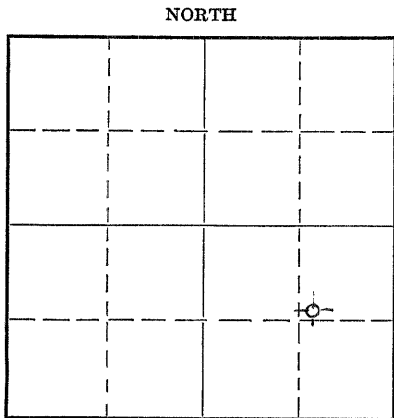

Locate well correctly on above
Section Flat

Rocks _____ County. Sec. 8 Twp. 9 Rge. 19 (E) (W)
Location as "NE/CNW $\frac{1}{4}$ SW $\frac{1}{4}$ " or footage from lines _____
Lease Owner Wentworth & Sons
Lease Name Ziegler Well No. 3
Office Address 910 Palace Building; Tulsa, Oklahoma
Character of Well (completed as Oil, Gas or Dry Hole) Dry Hole
Date well completed April 20, 1951 19
Application for plugging filed April 20, 1951 - By Telephone 19
Application for plugging approved Same date - By Telephone 19
Plugging commenced April 20, 1951 19
Plugging completed April 23, 1951 19
Reason for abandonment of well or producing formation Dry

If a producing well is abandoned, date of last production _____ 19
Was permission obtained from the Conservation Division or its agents before plugging was commenced? Yes

Name of Conservation Agent who supervised plugging of this well Mr. Petty - Great Bend, Kansas
Producing formation none Depth to top _____ Bottom _____ Total Depth of Well 3600' Feet
Show depth and thickness of all water, oil and gas formations.

OIL, GAS OR WATER RECORDS

CASING RECORD

Formation	Content	From	To	Size	Put In	Pulled Out
				8 5/8"	185'	None
				5 3/16"	3600'	3085'

Describe in detail the manner in which the well was plugged, indicating where the mud fluid was placed and the method or methods used in introducing it into the hole. If cement or other plugs were used, state the character of same and depth placed, from _____ feet to _____ feet for each plug set.

Plug set at 3525' - 25' chat placed on top of plug - Four sacks cement on top of chat - Hole then filled with mud to 185' - 15 sacks cement at 185', mud to 35' and 10 sacks of cement.

STATE OF KANSAS
5-7-51
MAY 7 - 1951
CONSERVATION DIVISION
Wichita, Kansas

(If additional description is necessary, use BACK of this sheet)

Correspondence regarding this well should be addressed to Wentworth & Sons
Address 910 Palace Building; Tulsa, Oklahoma

STATE OF Oklahoma, COUNTY OF Tulsa, ss.

_____ (employee of owner) or (owner or operator) of the above-described well, being first duly sworn on oath, says: That I have knowledge of the facts, statements, and matters herein contained and the log of the above-described well as filed and that the same are true and correct. So help me God.

(Signature) Claude Wentworth
910 Palace Building; Tulsa, Oklahoma
(Address)

SUBSCRIBED AND SWORN to before me this 2nd day of May, 1951

My commission expires 12-21-54 _____
Notary Public.

PLUGGING
FILE SEC. 87919W
BOOK PAGE 77 LINE 44

WENTWORTH & SONS
910 Palace Building
Tulsa, Oklahoma

Ziegler Lease - Well No. 3
SE 1/4, Section 8 Township 9S, Range 19 West
Rooks County, Kansas

Total Depth: 3600'

GEOLOGICAL TOPS:

Feet

3217	Kansas City
	Heebner
3255	Kansas City
3504	Conglomerate
3507	Arbuckle

SHOWS OF OIL GAS OR WATER:

Feet
From To

0	185	Shale and Lime	
185	275	Shale	
275	610	Shale and Shells	
610	785	Red Bed	
785	910	Shale and Lime	
910	940	Lime	
940	1155	Sand and Shale	
1155	1300	Shale and Shells	
1300	1400	Shale and Red Bed	
1400	1460	Shale and Shells	
1460	1495	Anhydrite	
1495	1560	Shale and Shells	
1560	1730	Shale and Lime	
1730	1860	Shale and Lime	
1860	2395	Shale and Lime	
2395	2560	Lime	
2560	2785	Shale and Lime	
2785	2855	Broken Shale and Lime	
2855	3025	Shale and Lime	
3025	3175	Lime	
3175	3227	Lime and Shale	
3227	3363	Lime	
3363	3402	Lime and Shale	
3402	3463	Lime	
3463	3498	Shale and Lime	
3498	3504	Lime	
3504	3517	Conglomerate	
3517	3525	Arbuckle	
3525	3534	Lime	
3534	3568	Lime (Cherty)	
3568	3600	Lime	TOTAL DEPTH

P L U G G E D

Date Commenced: 4-20-51
Date Completed: 4-23-51


PLUGGING
FILE SEC 8 T 9 R 19 W
BOOK PAGE 77 LINE 48