


STATE OF KANSAS
STATE CORPORATION COMMISSION

WELL PLUGGING RECORD

Give All Information Completely
Make Required Affidavit
Mail or Deliver Report to
Conservation Division
State Corporation Comm.
245 North Water
Wichita, KS 67202

Graham County. Sec. 18 Twp. 9S Rge. 21 XXW
Location as "NE/CNW $\frac{1}{4}$ SW $\frac{1}{4}$ " or footage from lines
SE SW SW

Lease Owner Murfin Drilling Company
Lease Name Forgy Well No. 2
Office Address 250 N. Water, Suite 300; Wichita, KS 67202
Character of Well (Completed as Oil, Gas or Dry Hole) Oil

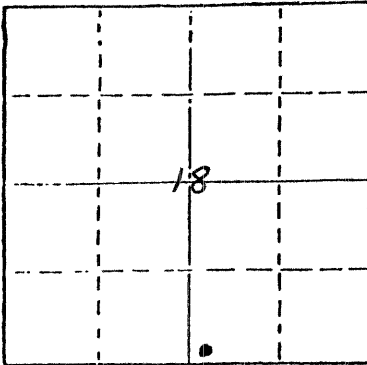

Locate well correctly on above
Section Plat

Date Well completed 4/12 1951
Application for plugging filed -- 19--
Application for plugging approved -- 19--
Plugging commenced 8/23 1984
Plugging completed 8/23 1984
Reason for abandonment of well or producing formation uneconomical

If a producing well is abandoned, date of last production Feb. 1973

Was permission obtained from the Conservation Division or its agents before plugging was commenced? yes

Name of Conservation Agent who supervised plugging of this well Carl Goodrow
Producing formation Arbuckle Depth to top 3843' Bottom TD Total Depth of Well 3847'
Show depth and thickness of all water, oil and gas formations.

OIL, GAS OR WATER RECORDS

CASING RECORD

FORMATION	CONTENT	FROM	TO	SIZE	PUT IN	PULLED OUT
				8 5/8"	139'	---
				5 1/2"	3844'	---

Describe in detail the manner in which the well was plugged, indicating where the mud fluid was placed and the method or methods used in introducing it into the hold. If cement or other plugs were used, state the character of same and depth placed, from feet to feet for each plug set.


Mixed and pumped down 5 1/2" casing: 50 sx. cement w/2 sx. gel and 3 sx. hulls followed by 10 sx. cement w/15 sx. gel, followed by 7 sx. gel. Released plug and pumped 90 sx. cement at 1000# max. press. Pumped 50 sx. cement down 8 5/8" and 5 1/2" annulus at 200# max. press.

(If additional description is necessary, use BACK of this sheet)

Name of Plugging Contractor Murfin Drilling Company

STATE OF Kansas COUNTY OF Sedgwick, ss.
P. T. Canaday, Jr. Engineer (employee of owner) or (owner or operator)
of the above-described well, being first duly sworn on oath, says: That I have knowledge of the facts, statements, and matters herein contained and the log of the above-described well as filed and that the same are true and correct. So help me God.

(Signature) By: [Signature]
250 N. Water, Suite 300; Wichita, Ks 67202
(Address)

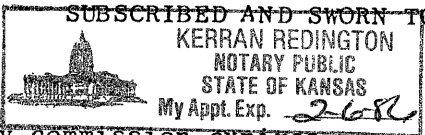SUBSCRIBED AND SWORN TO before me this 14 day of September, 19 84

My commission expires 2/6/86
Kerran Redington Notary Public.

RECEIVED
STATE CORPORATION COMMISSION
SEP 17 1984
9-17-84
CONSERVATION DIVISION
Wichita, Kansas