


STATE OF KANSAS  
STATE CORPORATION COMMISSION

WELL PLUGGING RECORD

Give All Information Completely  
Make Required Affidavit  
Mail or Deliver Report to  
Conservation Division  
State Corporation Comm.  
245 North Water  
Wichita, KS 67202

Graham County. Sec. 18 Twp. 9 Rge. 21 E/W  
Location as "NE/CNW $\frac{1}{4}$ SW $\frac{1}{4}$ " or footage from lines  
NW NW SW  
Lease Owner Murfin Drilling Company  
Lease Name Forgy Well No. 5  
Office Address 250 N. Water, Suite 300; Wichita, KS 67202  
Character of Well (Completed as Oil, Gas or Dry Hole) Oil

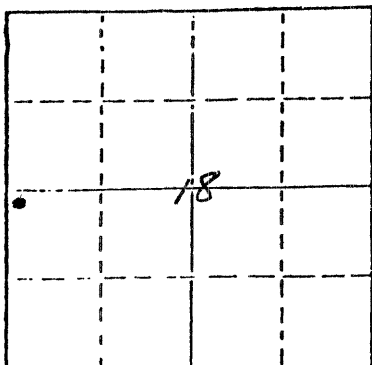

Locate well correctly on above  
Section Plat

Date Well completed 9/27 1951  
Application for plugging filed -- 19--  
Application for plugging approved -- 19--  
Plugging commenced 8/23 1984  
Plugging completed 8/23 1984  
Reason for abandonment of well or producing formation Uneconomical  
If a producing well is abandoned, date of last production Oct. 1982

Was permission obtained from the Conservation Division or its agents before plugging was commenced? yes

Name of Conservation Agent who supervised plugging of this well Carl Goodrow  
Producing formation Arbuckle Depth to top 3800' Bottom TD Total Depth of Well 3805'  
Show depth and thickness of all water, oil and gas formations.

OIL, GAS OR WATER RECORDS

CASING RECORD

FORMATION	CONTENT	FROM	TO	SIZE	PUT IN	PULLED OUT
				8 5/8"	182'	--
				5 1/2"	3803'	--

Describe in detail the manner in which the well was plugged, indicating where the mud fluid was placed and the method or methods used in introducing it into the hold. If cement or other plugs were used, state the character of same and depth placed, from \_\_\_\_\_ feet to \_\_\_\_\_ feet for each plug set.


Mixed and pumped down 5 1/2" casing: 50 sx. cement w/2 sx. gel and 3 sx. hulls, followed by 10 sx. cement w/15 sx. gel, followed by 7 sx. gel. Released plug and pumped 90 sx. cement at 500# max. press. Pumped 50 sx. cement down 8 5/8" and 5 1/2" annulus at 150# max. press.

(If additional description is necessary, use BACK of this sheet)

Name of Plugging Contractor Murfin Drilling Company

STATE OF Kansas COUNTY OF Sedgwick, ss.  
P. T. Canaday, Jr. Engineer (employee of owner) or (owner or operator)  
of the above-described well, being first duly sworn on oath, says: That I have knowledge of the facts, statements, and matters herein contained and the log of the above-described well as filed and that the same are true and correct. So help me God.

(Signature) By: P. T. Canaday, Jr.  
250 N. Water, Suite 300; Wichita, KS 67202  
(Address)

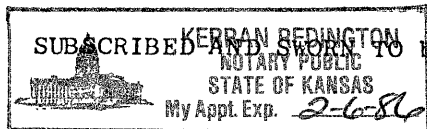

before me this 14 day of September, 1984

My commission expires 2/6/86 Kerran Redington

Notary Public.

RECEIVED  
STATE CORPORATION COMMISSION

SEP 17 1984  
9-17-84  
CONSERVATION DIVISION  
Wichita, Kansas