


STATE OF KANSAS
STATE CORPORATION COMMISSION

Give All Information Completely
Make Required Affidavit
Mail or Deliver Report to:
Conservation Division
State Corporation Commission
211 No. Broadway
Wichita, Kansas

WELL PLUGGING RECORD

NORTH

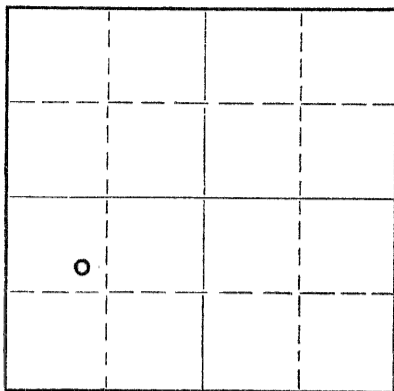

Locate well correctly on above
Section Plat

Graham County. Sec 29 Twp. 9 Rge. 21W (E) (W)
Location as "NE/CNW/SW" or footage from lines SE NW SW
Lease Owner C-G Drilling Co.
Lease Name Harrold Well No. 4
Office Address 107 Rule Building, Wichita, Kansas
Character of Well (completed as Oil, Gas or Dry Hole) Dry Hole
Date well completed October 24 1958
Application for plugging filed October 24 1958
Application for plugging approved October 24 1958
Plugging commenced October 24 1958
Plugging completed October 24 1958
Reason for abandonment of well or producing formation Too low structurally

If a producing well is abandoned, date of last production _____ 19____
Was permission obtained from the Conservation Division or its agents before plugging was commenced? Yes

Name of Conservation Agent who supervised plugging of this well Eldon Petty, Hays, Kansas
Producing formation _____ Depth to top _____ Bottom _____ Total Depth of Well 3924 Feet
Show depth and thickness of all water, oil and gas formations.

OIL, GAS OR WATER RECORDS

CASING RECORD

FORMATION	CONTENT	FROM	TO	SIZE	PUT IN	PULLED OUT
				8-5/8"	196.76'	none

Describe in detail the manner in which the well was plugged, indicating where the mud fluid was placed and the method or methods used in introducing it into the hole. If cement or other plugs were used, state the character of same and depth placed, from _____ feet to _____ feet for each plug set.

Filled hole with heavy mud to 600'. Set plug. Put in 20 sacks cement. Filled to 195'. Set plug. Put in 1/2 sack hulls and 20 sacks cement. Filled with heavy mud up to 40'. Set plug. Filled to top with 1/2 sack hulls and 10 sacks cement.

RECEIVED
STATE CORPORATION COMMISSION
10/29/58
OCT 29 1958

(If additional description is necessary, use BACK of this sheet)

Name of Plugging Contractor C-G Drilling Co.
Address 107 Rule Building, Wichita, Kansas

STATE OF KANSAS, COUNTY OF SEDGWICK, ss.
G. F. Galloway (employee of owner) or (owner or operator) of the above-described well, being first duly sworn on oath, says: That I have knowledge of the facts, statements, and matters herein contained and the log of the above-described well as filed and that the same are true and correct. So help me God.


(Signature) G. F. Galloway
107 Rule Building
(Address)

SUBSCRIBED AND SWORN TO before me this 28th day of October, 1958

My commission expires May 20, 1959

Vicky Jacobs
Vicky Jacobs Notary Public.

PLUGGING
FILE SEC 29 T 9 R 21W
BOOK PAGE 140 LINE 33

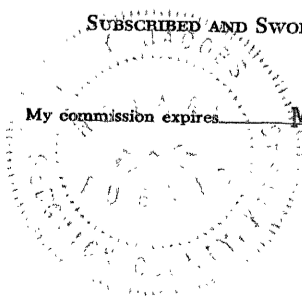

CONTRACTOR'S WELL LOG

OPERATOR C-G Drilling Co. WELL NAME Harrold #4
 LOCATION SE NW SW SEC. 29-9-21W RIG NO. 1
 COUNTY Graham STATE Kansas
 COMMENCEMENT DATE October 16, 1958 COMPLETION DATE October 24, 1958

LOG OF WELL

Elevation 2324' kelly bushing.
 All measurements taken from the top of kelly bushing.

FROM	TO	FORMATION	DEVIATION FROM VERTICAL	REMARKS:
0	196	Surface		
196	430	Shale		
430	980	Sand-Shale		
980	1100	Sand		
1100	1210	Shale		
1210	1380	Sand		
1380	1415	Sand-Shale		
1415	1802	Shale		
1802	1840	Anhydrite		
1840	1880	Shale-Shell		
1880	2150	Shale-Lime		
2150	2350	Lime-Shale		
2350	2545	Lime-Shale	0° - 2500	
2545	2660	Shale-Lime		
2660	2885	Lime-Shale	0° - 2750	
2885	3030	Shale-Lime	0° - 3000	
3030	3130	Lime-Shale		
3130	3300	Lime-Shale	0° - 3250	
3300	3410	Lime-Shale		
3410	3478	Lime-Shale		
3478	3555	Lime-Shale		
3555	3615	Lime		
3615	3673	Lime-Shale		
3673	3728	Lime		
3728	3800	Lime-Shale		
3800	3865	Lime-Shale		
3865	3901	Lime-Shale		
3901	3924	Conglomerate		

STRICTLY CONFIDENTIAL
 OCT 27 1958
 CONSERVATION DIVISION
 WICHITA, KANSAS

CASING LEFT IN HOLE AFTER COMPLETION

Ran 196.76' (10 jts.) 8-5/8" OD Surface Casing.

STATE OF KANSAS }
 COUNTY OF SEDGWICK } SS.

The undersigned hereby certifies that to the best of his knowledge and belief, the above facts are true and correct.

C-G DRILLING CO.

By G. F. Galloway
 G. F. Galloway

SUBSCRIBED AND SWORN TO BEFORE ME THIS 28th day of October, 1958.

Vicky Jacobs
 Vicky Jacobs, Notary Public

My commission expires: May 20, 1959



PLUGGING
 FILE SEC. 29 T. 9 R. 21W
 BOOK PAGE 140 LINE 33