


All Information Completely
Make Required Affidavit
Mail or Deliver Report to:
Conservation Division
State Corporation Commission
211 No. Broadway
Wichita, Kansas

WELL PLUGGING RECORD

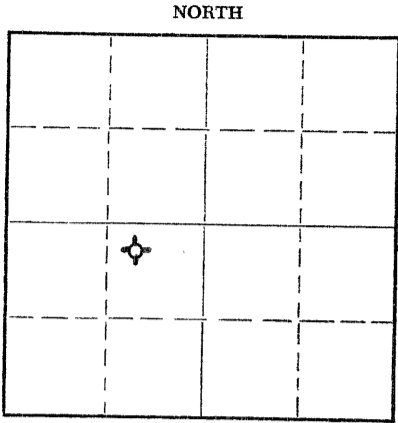

Locate well correctly on above
Section Plat

Graham County. Sec. 29 Twp. 9 Rge. 21W (E) (W)
Location as "NE/CNW/SW" or footage from lines NW NE SW
Lease Owner C-G Drilling Co.
Lease Name Harrold Well No. 3
Office Address 107 Rule Building, Wichita, Kansas
Character of Well (completed as Oil, Gas or Dry Hole) Dry Hole
Date well completed August 18 19 58
Application for plugging filed August 18 19 58
Application for plugging approved August 18 19 58
Plugging commenced August 18 19 58
Plugging completed August 19 19 58
Reason for abandonment of well or producing formation Too low structurally

If a producing well is abandoned, date of last production _____ 19____
Was permission obtained from the Conservation Division or its agents before plugging was commenced? Yes

Name of Conservation Agent who supervised plugging of this well Eldon Petty, Hays, Kansas
Producing formation _____ Depth to top _____ Bottom _____ Total Depth of Well 3962' Feet
Show depth and thickness of all water, oil and gas formations.

OIL, GAS OR WATER RECORDS

CASING RECORD

FORMATION	CONTENT	FROM	TO	SIZE	PUT IN	PULLED OUT
				8-5/8"	178.64'	none

Describe in detail the manner in which the well was plugged, indicating where the mud fluid was placed and the method or methods used in introducing it into the hole. If cement or other plugs were used, state the character of same and depth placed, from _____ feet to _____ feet for each plug set.

Filled hole with heavy mud to 600'. Set plug. Put in 25 sacks cement. Filled to 175'. Set plug. Put in 15 sacks cement & 1/2 sack hulls. Filled with heavy mud up to 40'. Set plug. Filled to top with 10 sacks cement and 1/2 sack hulls.

(If additional description is necessary, use BACK of this sheet)

Name of Plugging Contractor C-G Drilling Co.
Address 107 Rule Building, Wichita, Kansas

STATE OF KANSAS, COUNTY OF SEDGWICK, ss.


G. F. Galloway (employee of owner) or (owner or operator) of the above-described well, being first duly sworn on oath, says: That I have knowledge of the facts, statements, and matters herein contained and the log of the above-described well as filed and that the same are true and correct. So help me, God.

(Signature) G. F. Galloway
G. F. Galloway
107 Rule Building
(Address)

Subscribed AND SWORN TO before me this 25th day of August, 1958

My commission expires May 20, 1959

Vicky Jacobs
Vicky Jacobs
Notary Public.

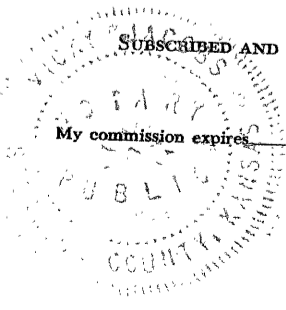

8/26/58

PLUGGING
FILE SEC 29 T 9 R 21W
BOOK PAGE 125 LINE 24

CONTRACTOR'S WELL LOG

OPERATOR C-G Drilling Co. WELL NAME Harrold #3
 LOCATION NW NE SW SEC. 29-9-21W RIG NO. 1
 COUNTY Graham STATE Kansas
 COMMENCEMENT DATE August 11, 1958 COMPLETION DATE August 18, 1958

LOG OF WELL

Elevation 2337' kelly bushing.
 All measurements taken from the top of kelly bushing.

FROM	TO	FORMATION	DEVIATION FROM VERTICAL	REMARKS:
0	178	Clay-Sand		
178	700	Shale		
700	1340	Shale		
1340	1480	Sand		
1480	1645	Shale-Sand		
1645	1807	Red Bed		
1807	1842	Anhydrite		
1842	2000	Shell-Shale		
2000	2330	Shale-Shell		
2330	2510	Shale-Lime	0° - 2500	
2510	2670	Lime-Shale		
2670	2900	Shale-Lime	0° - 2750	
2900	3030	Lime-Shale	0° - 3000	
3030	3140	Lime-Shale		
3140	3305	Shale-Lime	0° - 3250	
3305	3370	Lime-Shale		
3370	3480	Lime-Shale		
3480	3550	Lime-Shale		
3550	3601	Lime-Shale		DST 3572-3601'
3601	3603	Lime-Shale		
3603	3685	Lime		
3685	3745	Lime		
3745	3815	Lime-Shale		
3815	3890	Lime-Shale		
3890	3919	Lime-Shale		
3919	3962	Lime-Shale		

CASING LEFT IN HOLE AFTER COMPLETION

Ran 178.64' (9 jts.) 8-5/8" OD Surface Casing.

STATE OF KANSAS }
 COUNTY OF SEDGWICK } SS.

The undersigned hereby certifies that to the best of his knowledge and belief, the above facts are true and correct.

C-G DRILLING CO.

By G. F. Galloway
 G. F. Galloway

SUBSCRIBED AND SWORN TO BEFORE ME THIS 20th day of August, 1958.

Vicky Jacobs
 Vicky Jacobs, Notary Public

My commission expires: May 20, 1959

